

# OTTAWA COUNTY ENGINEERS OFFICE

REFERENCE NO. 7-6-14-F  
EAST QUARTER POST SEC 7  
HARRIS TWP.  
SHEET 1 OF 1.

ROUTE: C-208 ELLISTON TROWBRIDGE RD.

TOWNSHIP: HARRIS

SECTION: 7


T 6 NR 14 E.

PERSONNEL:  
M. WITTMAN, P.S.  
J. ALLEN  
J. LAUBACHER

NORTHING:

EASTING:

DATUM:

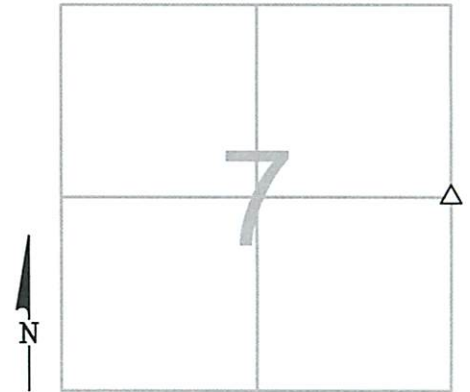

DATE / WEATHER / TEMP:

JULY 18, 2011  
SUNNY HUMID  
90° F

## MONUMENT INFORMATION

MONUMENT TYPE: FD 6" x 6" POINTED HARDHEAD  
ON SURFACE - BELOW: 1.15'  
LEFT - CL PAV'T - RIGHT: 7.15'



## MISC. INFORMATION

FD PK NAIL 0.33' BELOW SURFACE, TIED W/  
X-TIES & DUG FOR STONE

USED POINT (CENTER) OF STONE

PK NAIL WAS 0.01' W & 0.01' N OF CENTER OF  
THE STONE

JULY 18, 2011

SET 1" SQUARE IRON PIN  
IN MONUMENT BOX OVER  
STONE

