

OTTAWA COUNTY ENGINEERS OFFICE

REFERENCE NO. 8-6-14-A
NW CORNER POST SECTION 8
HARRIS TWP.
SHEET 1 OF 1.

ROUTE: C-208 ELLISTON TROWBRIDGE RD
@ T-57 DENO RD

TOWNSHIP: HARRIS

SECTION: 8

T 6 **NR** 14 **E.**


NORTHING:

EASTING:

DATUM:

PERSONNEL:
M. WITTMAN, P.S.
J. ALLEN
J. LAUBACHER

DATE / WEATHER / TEMP:
JULY 19, 2011
PARTLY SUNNY NW
88° F

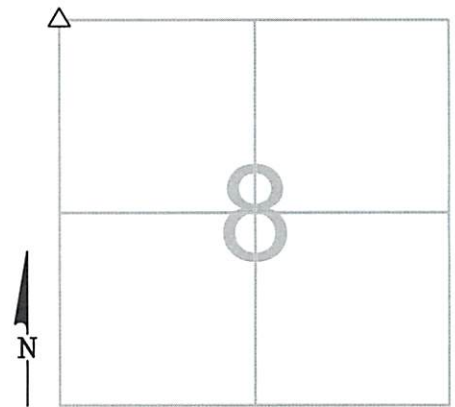

MONUMENT INFORMATION

MONUMENT TYPE: FD 6"X 12" HARDHEAD STONE
ON SURFACE - BELOW: 1.56'
LEFT - CL PAV'T - RIGHT: 1.80'



MISC. INFORMATION

FD PK NAIL 0.21' BELOW SURFACE
TIED W/ X-TIES, DUG FOR STONE
USED HIGH POINT OF STONE
FD PK NAIL WAS 0.02' S AND 0.03' E

JULY 19, 2011

SET 1" SQUARE IRON PIN
IN MONUMENT BOX OVER
STONE

