


# OTTAWA COUNTY ENGINEERS OFFICE

REFERENCE NO. 8-6-14-C  
 NE CORNER SECTION 8  
 HARRIS TWP.  
 SHEET 1 OF 1.

ROUTE: T-19 GRAYTOWN RD.  
 TOWNSHIP: HARRIS  
 SECTION: 8  
 T 6 NR 14 E.

PERSONNEL:  
 M. WITTMAN, P.S.  
 J. ALLEN  
 M. ULLRICH  
 S. ULLRICH

NORTHING:  
 EASTING:  
 DATUM:

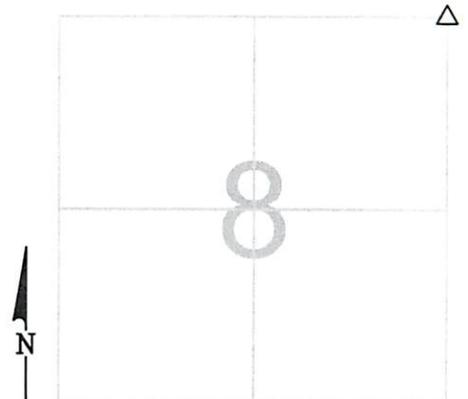

DATE / WEATHER / TEMP:  
 JULY 10, 2008  
 SUNNY S  
 80° F

### MONUMENT INFORMATION

MONUMENT TYPE: FD. 6" X 8" POINTED  
 LIMESTONE W/ NORTH -SOUTH NOTCH ON HIGH  
 POINT  
 ON SURFACE - BELOW: 1.45'  
LEFT - CL PAV'T - RIGHT: 5.45'



### MISC. INFORMATION

FD. RR SPIKE 0.30' BELOW SURFACE, TIED IT  
 DOWN W/ X-TIES: DUG FOR STONE, FD. RR  
 SPIKE 0.86' UNDER ORIGINAL RR SPIKE.  
 CONTINUED DOWN TO STONE. RR SPIKE 0.12'  
 NE OF POINT ON STONE

JULY 10, 2008

SET 1" SQUARE IRON PIN  
 IN MONUMENT BOX OVER  
 STONE

