

OTTAWA COUNTY ENGINEERS OFFICE

REFERENCE NO. 9-6-14-D
WEST QUARTER POST SEC. 9
HARRIS TWP.
SHEET 1 OF 1.

ROUTE: STATE ROUTE #105
@ T-19 GRAYTOWN RD.

TOWNSHIP: HARRIS

SECTION: 9

T 6 NR 14 E.


NORTHING:

EASTING:

DATUM:

PERSONNEL:
M. WITTMAN, P.S.
J. ALLEN

DATE / WEATHER / TEMP:
MAY 3, 2012
SUNNY SW
87° F

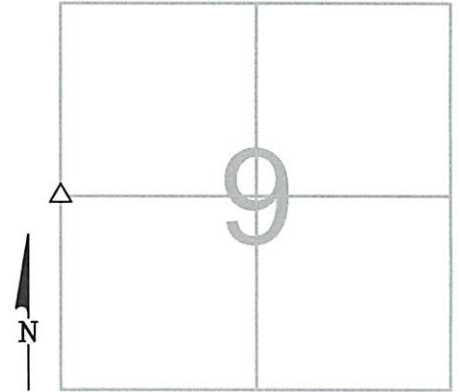

MONUMENT INFORMATION

MONUMENT TYPE: FD 5 $\frac{1}{2}$ " X 7" STONE
ON SURFACE - BELOW: 0.63'
LEFT - CL PAV'T - RIGHT: 27'

STONE INSIDE OF 12" Ø CLAY TILE

TILE AT SURFACE



MISC. INFORMATION

WEST EDGE OF STONE OS TURNED UP CREATING
A HIGH RIDGE, USED CENTER OF HIGH RIDGE

SET ORANGE SURVEY MARKER POST 1' SOUTH OF
STONE

