

OTTAWA COUNTY ENGINEERS OFFICE

REFERENCE NO. 9-6-14-G
SW CORNER POST SEC. 9
HARRIS TWP.
SHEET 1 OF 1.

PERSONNEL:
M. WITTMAN, P.S.
J. ALLEN

DATE / WEATHER / TEMP:
APRIL 24, 2012
SUNNY N-NW
56° F

ROUTE: T-46 LINKER-PORTAGE RD.

TOWNSHIP: HARRIS


SECTION: 9

T 6 NR 14 E.

NORTHING:


EASTING:

DATUM:

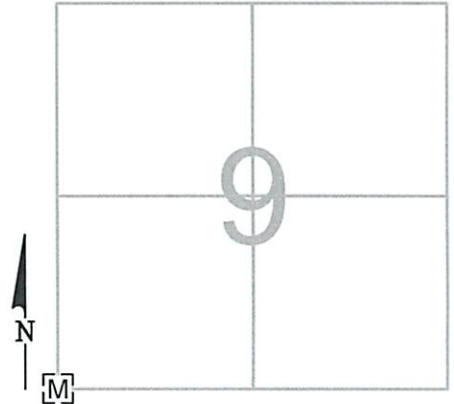

MONUMENT INFORMATION

MONUMENT TYPE: FD 1" SQ. IRON PIN IN MON. BOX
ON SURFACE - BELOW: 0.16'
LEFT - CL PAV'T - RIGHT: 0.45'

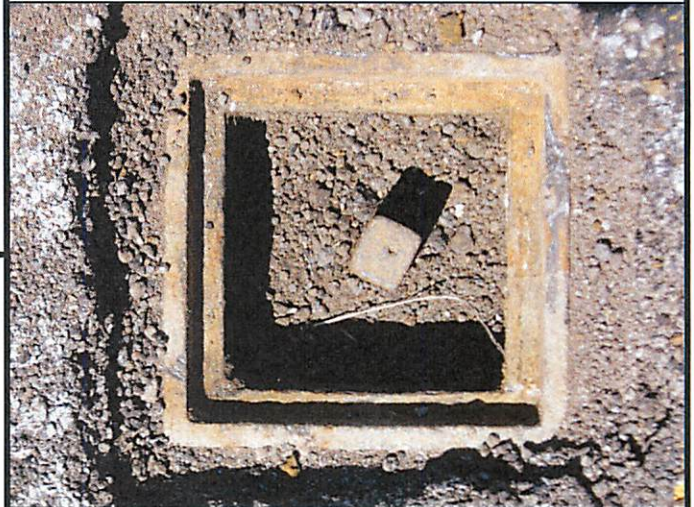

MISC. INFORMATION

PLACED RISER TO BRING TO SURFACE

