

OTTAWA COUNTY ENGINEERS OFFICE

REFERENCE NO. 11-6-17-J
 WEST 1/16 POST N. LINE SEC. 11
 PORTAGE TWP.
SHEET 1 OF 1.

ROUTE: C-33 GYPSUM RD.

TOWNSHIP: PORTAGE


SECTION: 11

T 6 **NR** 17 **E.**

NORTHING:

EASTING:

DATUM:

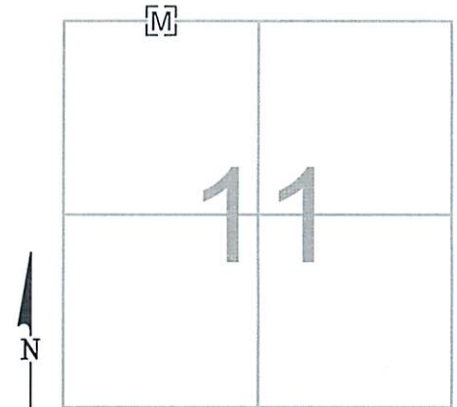

PERSONNEL:
 M. WITTMAN, P.S.
 J. ALLEN

DATE / WEATHER / TEMP:
 AUGUST 28, 2018
 SUNNY - SE
 84° F - HUMID

MONUMENT INFORMATION

MONUMENT TYPE: FD. RR SPIKE IN MON BOX
 ON SURFACE - BELOW: 0.43'
 LEFT - CL PAV'T - RIGHT: 4.85'

MON BOX WAS PACKED SOLID WITH ASPHALT, RR
 SPIKE WAS SOLID.



MISC. INFORMATION

FD. RR SPIKE IN DIG HOLE 0.43' BELOW SURFACE,
 TIED W/ X-TIES AND DUG FOR MON BOX OF
 RECORD. RR SPIKE WAS DRIVEN TO REFUSAL.
 SET MONUMENT BOX OVER EXISTING MONUMENT
 BOX.

AUGUST 28, 2018

SET MONUMENT BOX OVER
 EXISTING MONUMENT BOX

