

OTTAWA COUNTY ENGINEERS OFFICE

REFERENCE NO. 11-6-17-0
 CENTER WEST 1/16 POST SEC. 11
 PORTAGE TWP.
 SHEET 1 OF 1.

ROUTE: C-33 GYPSUM RD.

TOWNSHIP: PORTAGE

SECTION: 11

T 6 NR 17 E.


PERSONNEL:
 M. WITTMAN, P.S.
 J. ALLEN

NORTHING:

EASTING:

DATE / WEATHER / TEMP:
 AUGUST 10, 2018
 OVERCAST
 80° F - HUMID

DATUM:

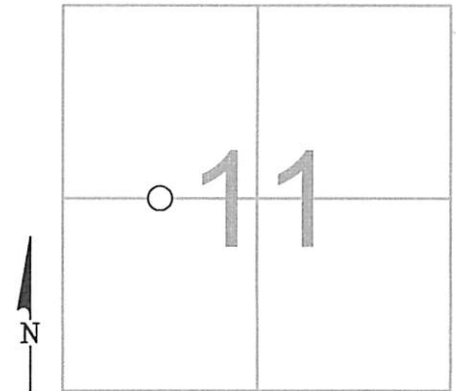

MONUMENT INFORMATION

MONUMENT TYPE: FD. 5/8" Ø IRON PIN
 ON SURFACE - BELOW: 1.26'
 LEFT - CL PAV'T - RIGHT: 1.60'

5/8" Ø IRON PIN PER RECORD. TOP 3" ARE BENT
 NORTH.



MISC. INFORMATION

SET 1" SQ. IRON PIN IN MONUMENT BOX OVER
 FD. IRON PIN. USED POINT WHERE PIN WAS
 TRAIGHT INTO THE GROUND AS POINT.

AUGUST 10, 2018

SET 1" SQUARE IRON PIN IN
 MONUMENT BOX OVER FD.
 IRON PIN

