

# OTTAWA COUNTY ENGINEERS OFFICE

**REFERENCE NO.** 2-6-17-0  
 CENTER W 1/16 POST SEC. 2  
 PORTAGE TWP.  
**SHEET** 1 OF 1.

**ROUTE:** C-8 STATE RD.  
 @ C-33 GYPSUM RD.

**TOWNSHIP:** PORTAGE

**SECTION:** 2

T 6 NR 17 E.


**PERSONNEL:**  
 M. WITTMAN, P.S.  
 J. ALLEN  
 C. MILLER

**NORTHING:**

**EASTING:**

**DATUM:**

**DATE / WEATHER / TEMP:**  
 SEPTEMBER 2, 2020  
 OVERCAST - HUMID  
 75° F

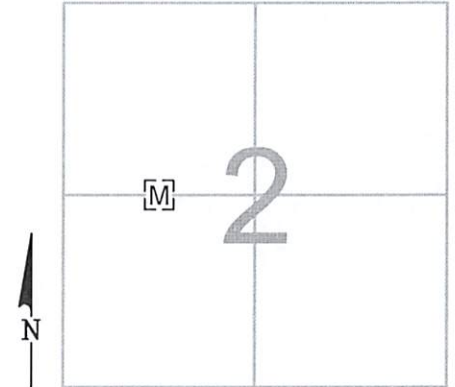

### MONUMENT INFORMATION

MONUMENT TYPE: FD. 2 1/2" Ø ODOT DISK IN MON BOX  
 ON SURFACE - BELOW: 1.03'  
LEFT - CL PAV'T - RIGHT: 0.65' STATE ROAD  
LEFT - CL PAV'T - RIGHT: 3.90' GYPSUM ROAD  
 SET DRILL HOLE IN CENTER OF DISK



### MISC. INFORMATION

ALL MEASUREMENTS TAKEN PRIOR TO  
 WIDENING OF INTERSECTION. SET NEW  
 MONUMENT BOX OVER EXISTING MONUMENT  
 BOX TO BRING TO SURFACE.

SEPTEMBER 2, 2020

SET MONUMENT BOX OVER  
 ODOT DISK IN MONUMENT BOX

