

OTTAWA COUNTY ENGINEERS OFFICE

REFERENCE NO. 3-6-17-E
INTERIOR CORNER POST SEC. 3
PORTAGE TWP.
SHEET 1 OF 1.

ROUTE: C-8 STATE RD.
@ VACATED CHRISTY CHAPEL RD.

TOWNSHIP: PORTAGE

SECTION: 3

T 6 NR 17 E.


NORTHING:

EASTING:

DATUM:

PERSONNEL:
M. WITTMAN, P.S.
J. ALLEN
K. BECK

DATE / WEATHER / TEMP:
JUNE 25, 2010
SUNNY
74° F

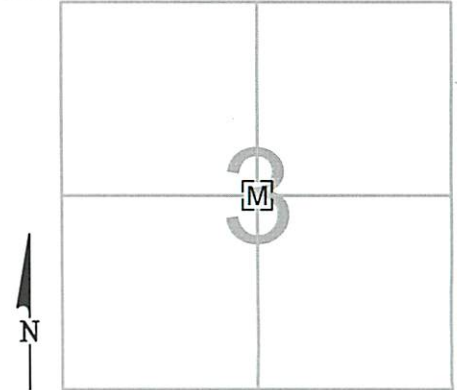

MONUMENT INFORMATION

MONUMENT TYPE: FD. 1" Ø IRON PIN IN MONUMENT
BOX
ON SURFACE - BELOW: 0.30'
LEFT - CL PAV'T - RIGHT: 2.50'



MISC. INFORMATION

