

OTTAWA COUNTY ENGINEERS OFFICE


REFERENCE NO. 6-6-16-G
SW CORNER POST SEC. 6
PORTAGE TWP.
SHEET 1 OF 1.

PERSONNEL:
M. WITTMAN, P.S.
J. ALLEN

DATE / WEATHER / TEMP:
AUGUST 30, 2012
SUNNY - S
81° F

ROUTE:
TOWNSHIP: PORTAGE
SECTION: 6
T 6 NR 16 E.

NORTHING:
EASTING:
DATUM:

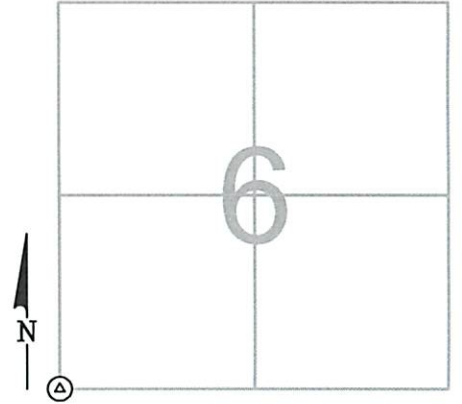

MONUMENT INFORMATION

MONUMENT TYPE: FD. BRASS DISK IN CONCRETE
ON SURFACE - BELOW:
LEFT - CL PAV'T - RIGHT:



MISC. INFORMATION

