

# OTTAWA COUNTY ENGINEERS OFFICE


**REFERENCE NO.** 7-6-16-A  
 NW CORNER POST SEC. 7  
 PORTAGE TWP.  
**SHEET** 1 OF 1.

**PERSONNEL:**  
 M. WITTMAN, P.S.  
 J. ALLEN

**DATE / WEATHER / TEMP:**  
 AUGUST 30, 2012  
 SUNNY - S  
 81° F

**ROUTE:**  
**TOWNSHIP:** PORTAGE  
**SECTION:** 7  
 T 6 NR 16 E.

**NORTHING:**  
**EASTING:**  
**DATUM:**

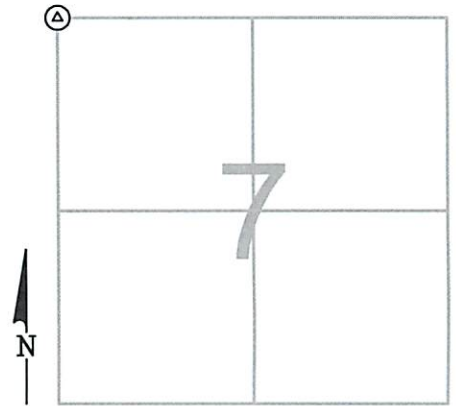

### MONUMENT INFORMATION

MONUMENT TYPE: FD. BRASS DISK IN CONCRETE  
ON SURFACE - BELOW:  
 LEFT - CL PAV'T - RIGHT:



### MISC. INFORMATION

