
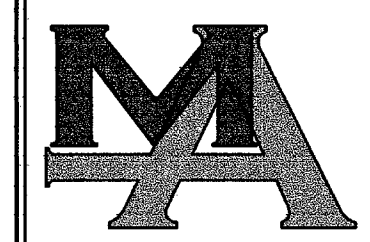


NOTICE
 THIS ARCHITECTURAL AND
 ENGINEERING DRAWING IS
 GIVEN IN CONFIDENCE. NO
 USE OR DISSEMINATION MAY
 BE MADE WITHOUT PRIOR
 WRITTEN CONSENT OF THE
 ARCHITECT. ALL RIGHTS ARE
 SPECIFICALLY RESERVED.
 MILLOY ARCHITECTS, L.L.C.
 COPYRIGHT YEAR 2005

DATES & REVISIONS
 082506 ISSUED TO OWNER

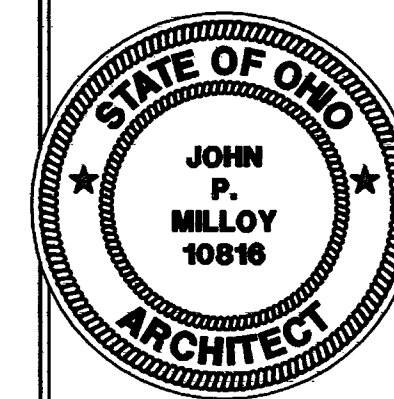


MILLOY ARCHITECTS, L.L.C.
 3409 LIBERTY AVENUE
 SUITE 200, P.O. BOX 12
 VERMILION, OHIO 44089
 JPM@ERIENET.NET

FLOOR PLANS
**SOUTH SHORE BEACH
 CONDOMINIUMS**
 1230 TRI-MOTOR DRIVE PUT-IN-BAY, OHIO 43456

PROJECT NO. 06C22
 DRAWN BY NDM
 CHECKED BY JFM


SHEET NO.
A-1

TELEPHONE:
 440-967-4904
 440-967-3005 fax

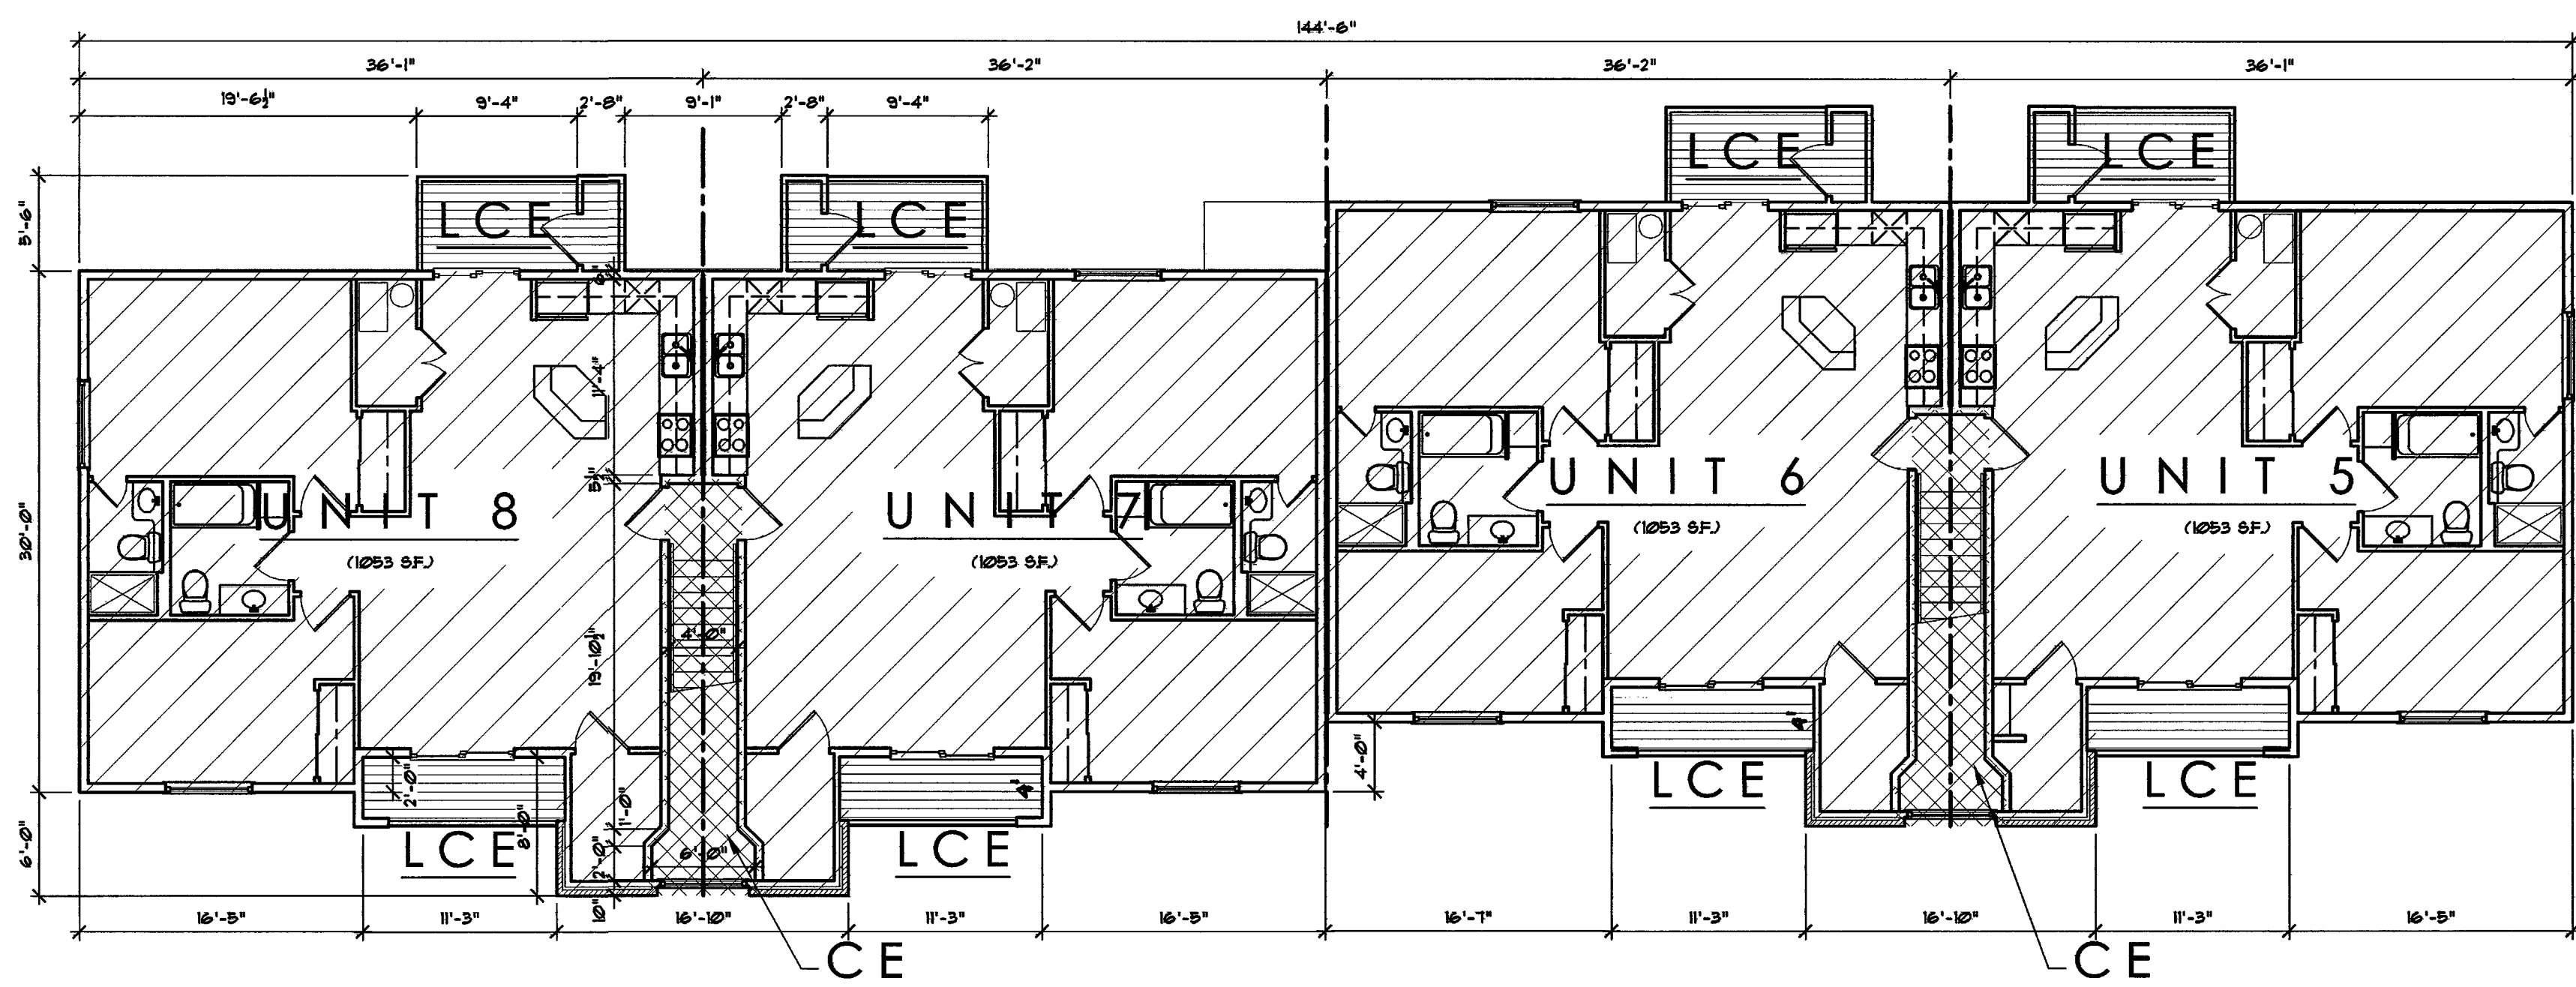

SECOND FLOOR PLAN

SCALE: 1/8" = 1'-0"

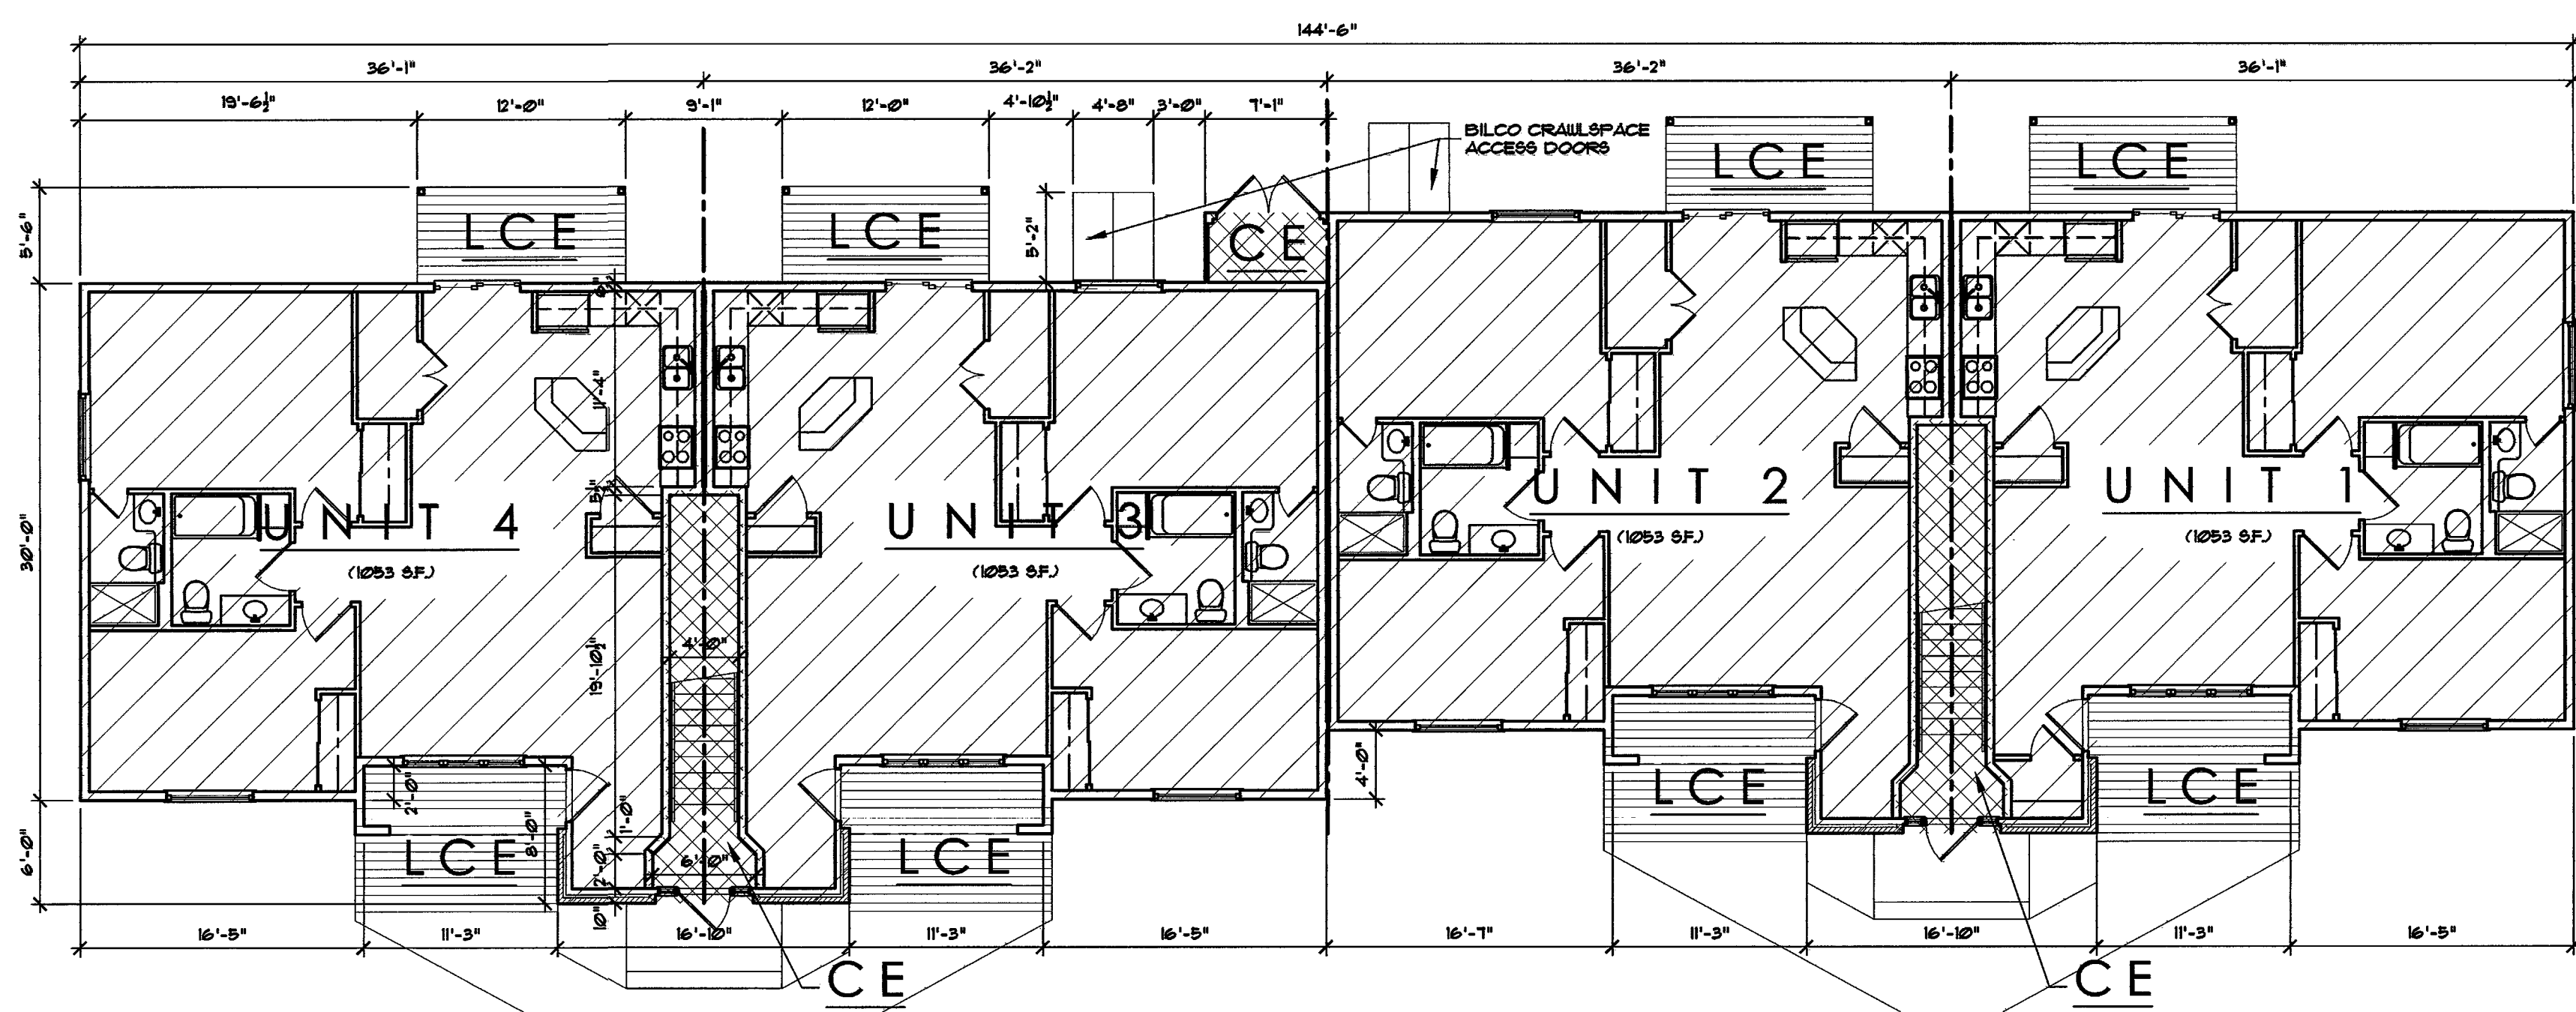


FIRST FLOOR PLAN

SCALE: 1/8" = 1'-0"

AREA LEGEND


LIVING UNIT-----	
LIMITED COMMON ELEMENT: PATIOS AND DECKS	
COMMON ELEMENT	

I CERTIFY THAT THIS DRAWING ACCURATELY SHOW EACH BUILDING AS BUILT OR CONSTRUCTED, PLUS OR MINUS 1.00"
John P. Milloy, R.A.
 JOHN P. MILLOY ARCHITECT
 REG. #10816

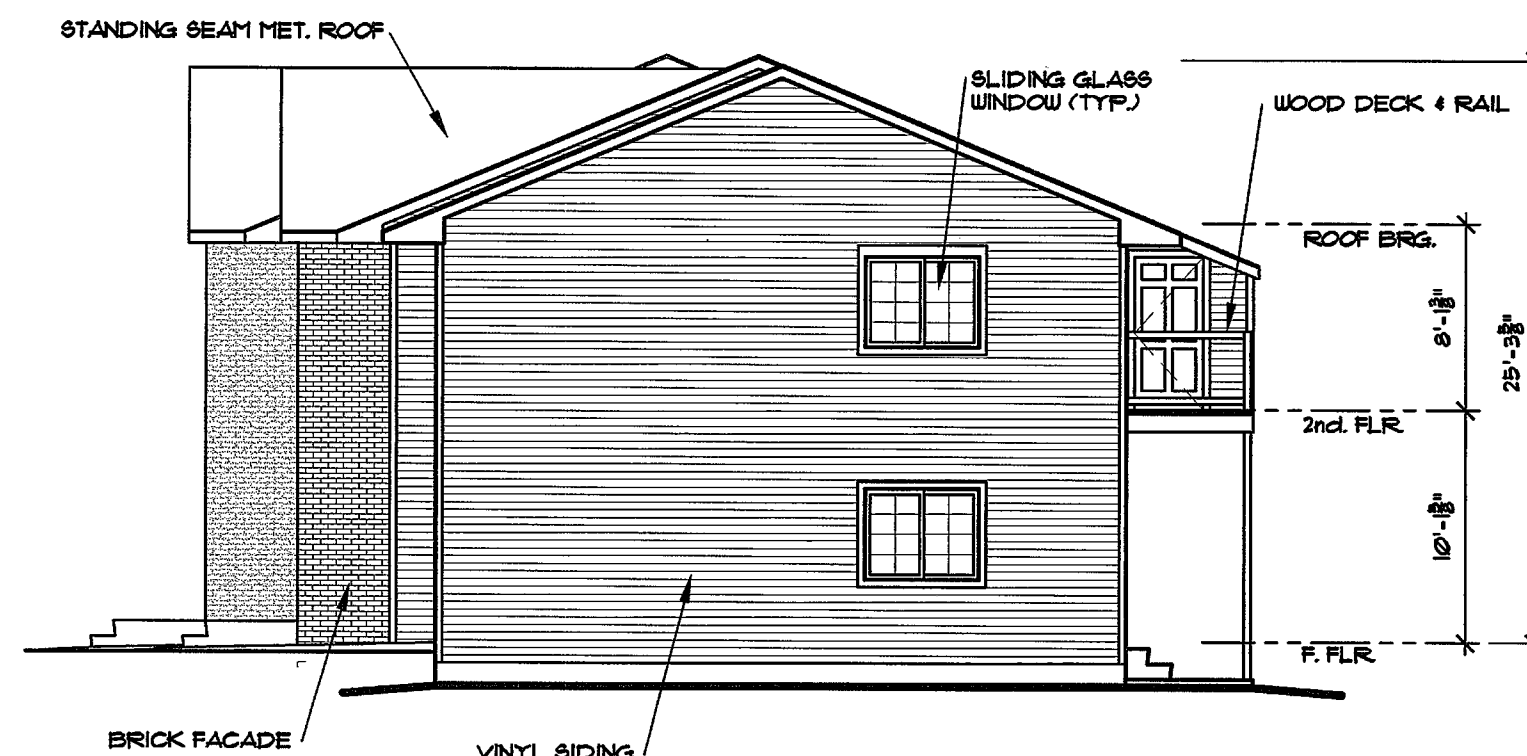


EAST ELEVATION

SCALE: 1/8" = 1'-0"

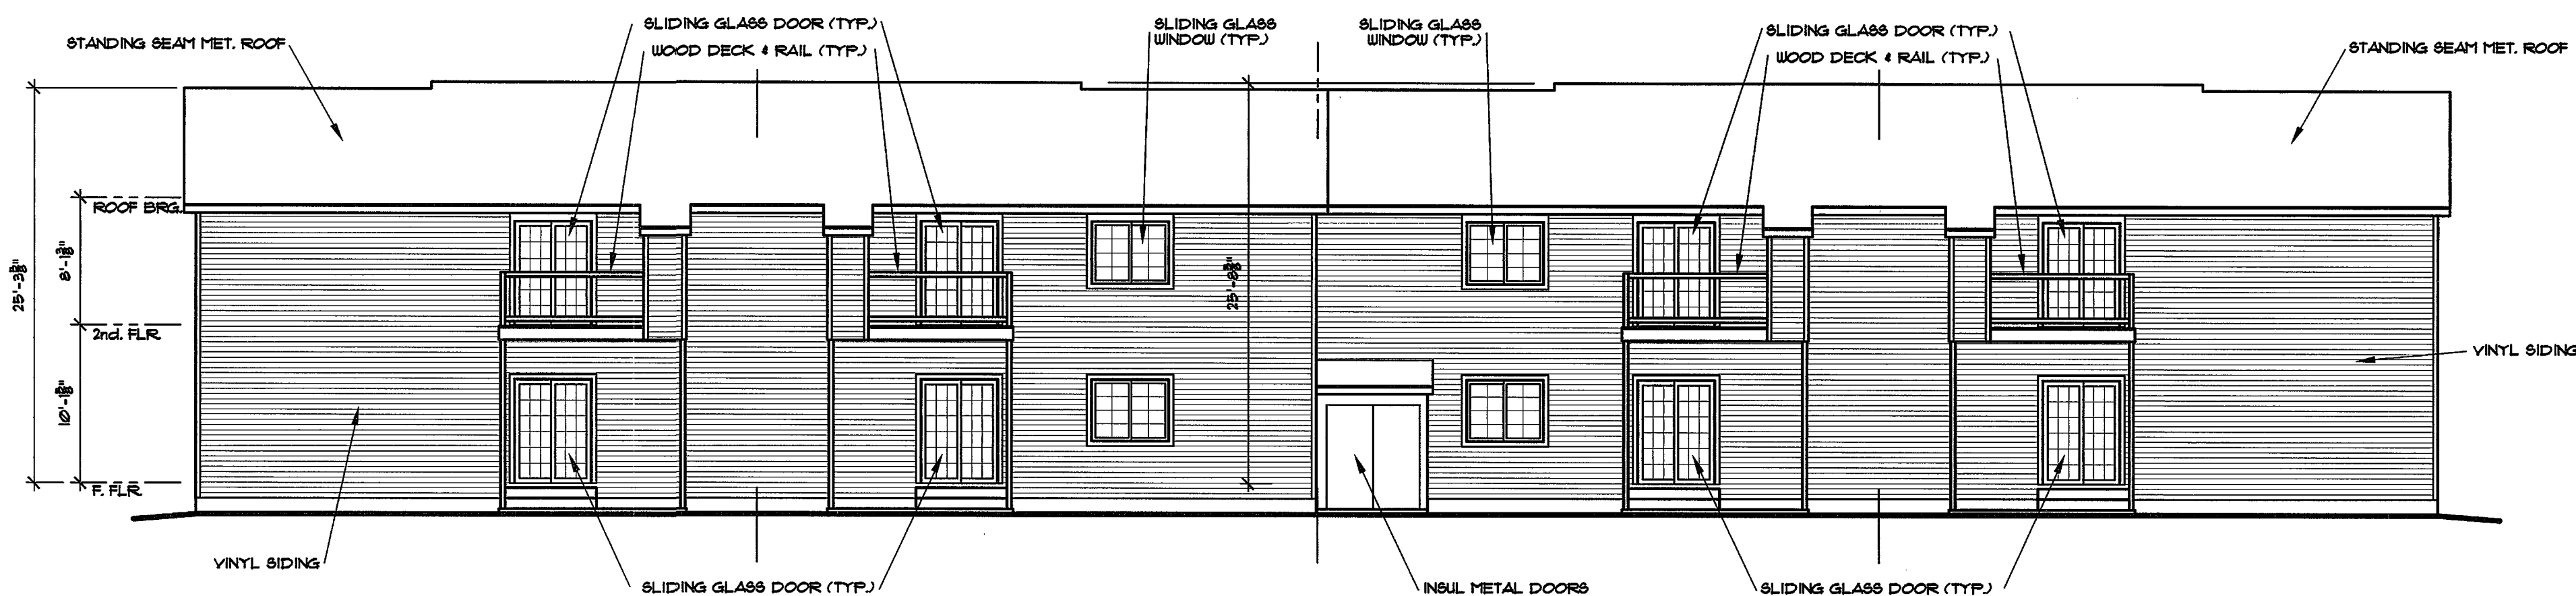

NORTH ELEVATION

SCALE: 1/8" = 1'-0"


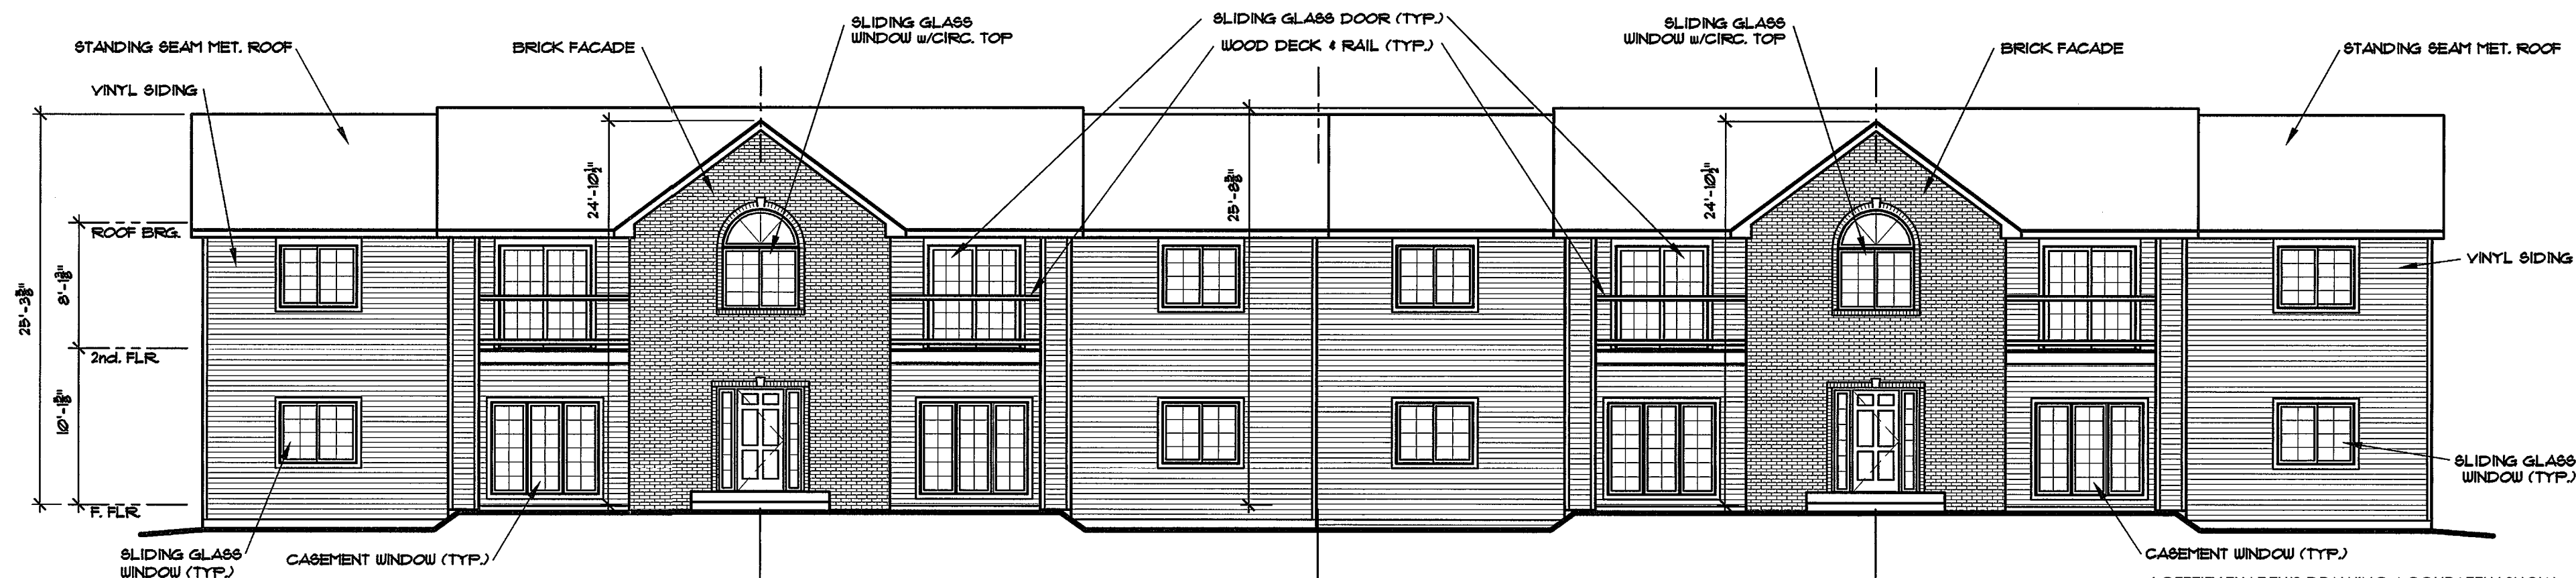


SOUTH ELEVATION

SCALE: 1/8" = 1'-0"

NOTICE
THIS ARCHITECTURAL AND ENGINEERING DRAWING IS GIVEN IN CONFIDENCE. NO USE OR DISSEMINATION MAY BE MADE WITHOUT PRIOR WRITTEN CONSENT OF THE ARCHITECT. ALL RIGHTS ARE SPECIFICALLY RESERVED.
MILLOY ARCHITECTS, LLC.
COPYRIGHT YEAR 2005

DATES & REVISIONS
082506 ISSUED TO OWNER

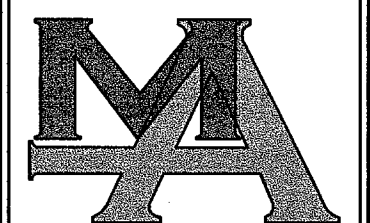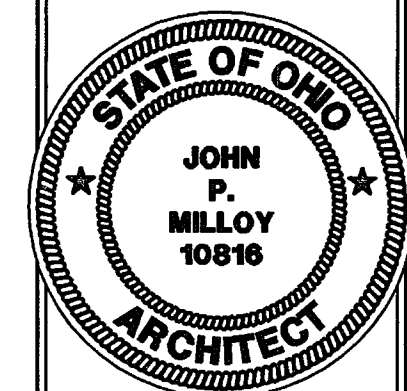

MILLOY ARCHITECTS, LLC.
3409 LIBERTY AVENUE
SUITE 200, P.O. BOX 12
VERMILION, OHIO 44089
JPM@ERIENET.NET

EXTERIOR ELEVATIONS
**SOUTH SHORE BEACH
CONDOMINIUMS**
1230 TRI-MOTOR DRIVE PUT-IN-BAY, OHIO 43456

PROJECT NO. 06C22
DRAWN BY NDM
CHECKED BY JPM

SHEET NO.
A-2

TELEPHONE:
440-967-4904
440-967-3005 fax

I CERTIFY THAT THIS DRAWING ACCURATELY SHOWS EACH BUILDING AS BUILT OR CONSTRUCTED, PLUS OR MINUS 1.00"
John P. Milloy, R.A.
JOHN P. MILLOY, ARCHITECT
REG. #10816