

CERTIFICATION
 These drawings, sheets A-1 thru A-5, accurately show the building as constructed.

Paul J. McGee
 ARCHITECT
 100 W. Main Street, 2nd Fl.
 Port Clinton, Ohio 43452

David B. Baker
 I hereby certify that the structure shown on these drawings is in accordance with the specifications shown.



David B. Baker
 9311 W. Long Road
 Oak Harbor, Ohio 43449
 E.D. 48314

INSPECTION CONCURRENCES
 Inspected by: _____
 Date: _____

SITE PLAN
 Scale: 1/8" = 1'-0"

EXHIBIT 'B'

PROJECT NO.	0218010104
DATE	11/11/88
BY	DAVID B. BAKER
CHECKED BY	DAVID B. BAKER
SCALE	1/8" = 1'-0"

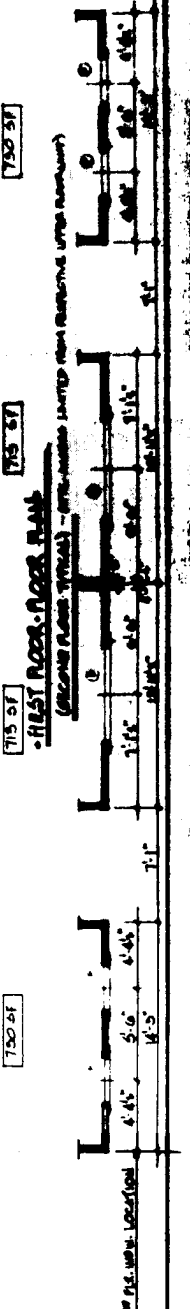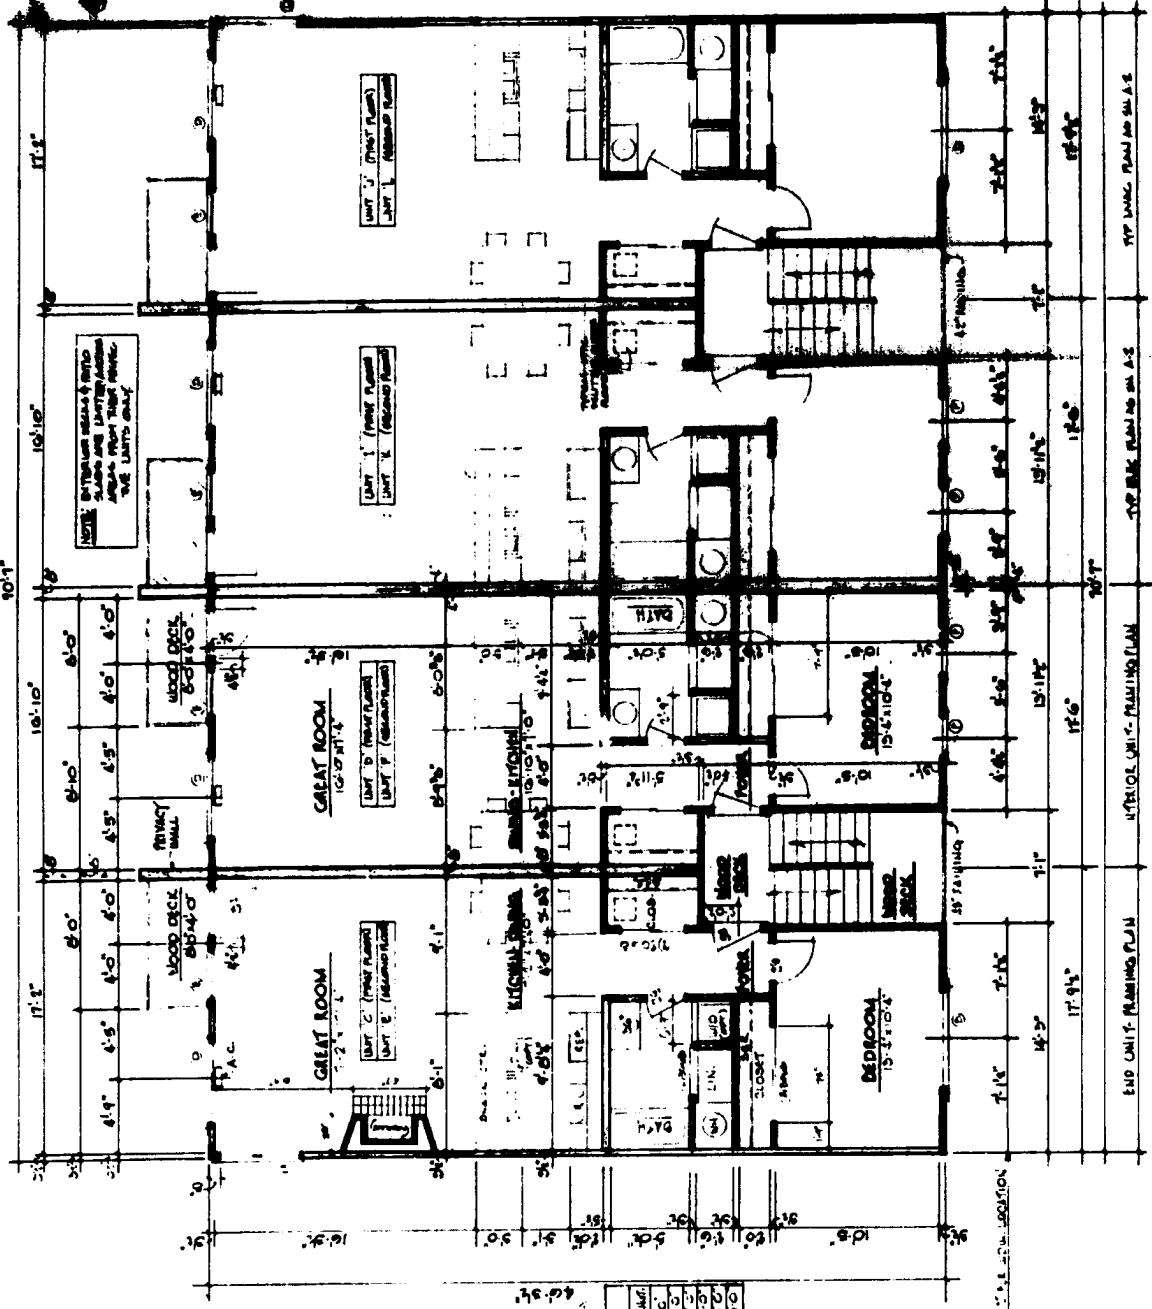

NOT SCALE TO LOCATION

NO. 100 1/2" x 100 1/2" JOIST

NO.	DESCRIPTION	QTY	UNIT
1	2x10 JOIST	12	LINEAL FEET
2	2x10 JOIST	12	LINEAL FEET
3	2x10 JOIST	12	LINEAL FEET
4	2x10 JOIST	12	LINEAL FEET
5	2x10 JOIST	12	LINEAL FEET
6	2x10 JOIST	12	LINEAL FEET
7	2x10 JOIST	12	LINEAL FEET
8	2x10 JOIST	12	LINEAL FEET
9	2x10 JOIST	12	LINEAL FEET
10	2x10 JOIST	12	LINEAL FEET

FIRST FLOOR PLAN
 (SECOND FLOOR TRUSS) - SEE SECOND FLOOR PLAN FOR DETAILS

75'-0" x 101'-1"

100 1/2" x 100 1/2" JOIST