

OTTAWA COUNTY ENGINEERS OFFICE

REFERENCE NO. 10-6-15-F
EAST QUARTER POST SEC. 10
SALEM TWP.
SHEET 1 OF 1.

ROUTE: C-18 PORTAGE RIVER SOUTH RD.
@ T-226 GORDON RD.

TOWNSHIP: SALEM

SECTION: 10

T 6 NR 15 E.

PERSONNEL:

M. WITTMAN, P.S.
J. ALLEN
B. JEFFRIES
S. ULLRICH


NORTHING:

EASTING:

DATUM:

DATE / WEATHER / TEMP:

JUNE 12, 2008
SUNNY S
84° F

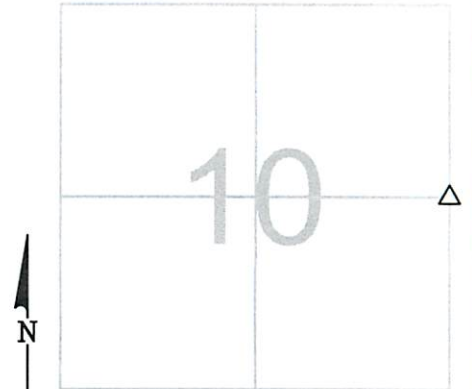

MONUMENT INFORMATION

MONUMENT TYPE: FD POINTED LIMESTONE
ON SURFACE - BELOW: 1.76'
LEFT - CL PAV'T - RIGHT: 6.0'

RECTANGULAR STONE: 4" x 2"



MISC. INFORMATION

JUNE 12, 2008

SET 1" SQUARE IRON PIN
IN MONUMENT BOX OVER
STONE

