

OTTAWA COUNTY ENGINEERS OFFICE

REFERENCE NO. 10-6-15-G
SW CORNER POST SEC. 10
SALEM TWP.
SHEET 1 OF 1.

ROUTE: T-169 WOODRICK RD.
@ T-107 CULLMAN RD.

TOWNSHIP: SALEM

SECTION: 10

T 6 NR 15 E.

PERSONNEL:
M. WITTMAN, P.S.
J. ALLEN


NORTHING:

EASTING:

DATUM:

DATE / WEATHER / TEMP:

MARCH 29, 2012
OVERCAST - NE
49° F

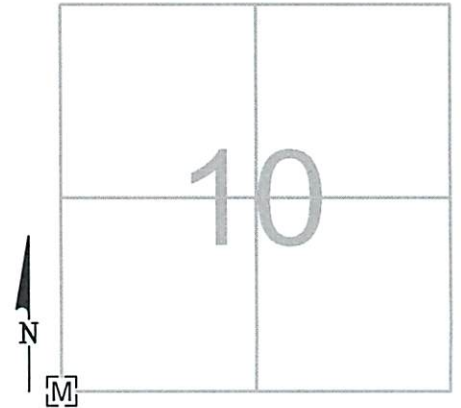

MONUMENT INFORMATION

MONUMENT TYPE: FD 1" SQ. IRON PIN IN MON. BOX
ON SURFACE - BELOW: 0.37'
LEFT - CL PAV'T - RIGHT: 2.60'
PLACED RISER TO BRING TO SURFACE



MISC. INFORMATION

