

OTTAWA COUNTY ENGINEERS OFFICE

REFERENCE NO. 10-6-15-H
SOUTH QUARTER POST SEC. 10
SALEM TWP.
SHEET 1 OF 1.

ROUTE: C-17 OAK HARBOR SE RD.

TOWNSHIP: SALEM

SECTION: 10

T 6 NR 15 E.


PERSONNEL:

M. WITTMAN, P.S.
J. ALLEN
B. BRADY
T. FOCHT

NORTHING:

EASTING:

DATUM:

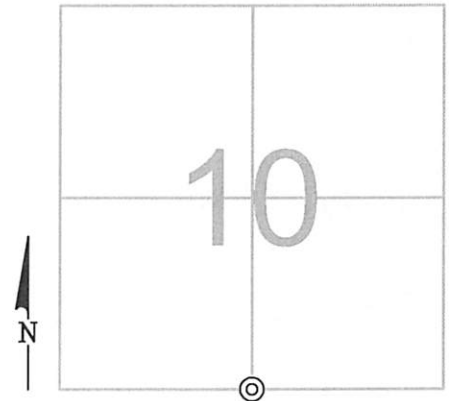


DATE / WEATHER / TEMP:

MAY 8, 2023
OVERCAST - NE
54° F

MONUMENT INFORMATION

MONUMENT TYPE: FD 3/4" Ø IRON PIPE
ON SURFACE - BELOW: 0.64'
LEFT - CL PAV'T - RIGHT: 0.70'

IRON PIPE PER RECORDS AND ROAD PLAN

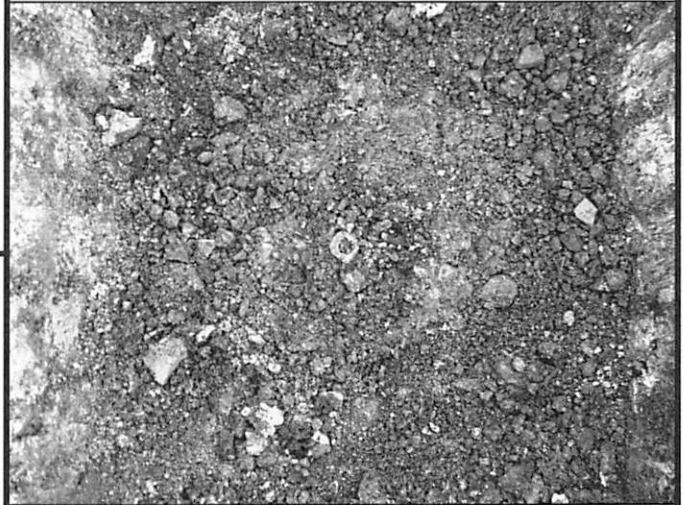

MISC. INFORMATION

MAY 8, 2023

SET MONUMENT BOX OVER
3/4" Ø IRON PIPE

