

OTTAWA COUNTY ENGINEERS OFFICE

REFERENCE NO. 10-6-15-I
SE CORNER POST SEC. 10
SALEM TWP.
SHEET 1 OF 1.

PERSONNEL:
M. WITTMAN, P.S.
J. ALLEN
C. MILLER
B. BRADY

DATE / WEATHER / TEMP:
APRIL 18, 2023
OVCAST - S
45° F

ROUTE: C-17 OAK HARBOR SE RD.

TOWNSHIP: SALEM


SECTION: 10

T 6 NR 15 E.

NORTHING:

EASTING:

DATUM:

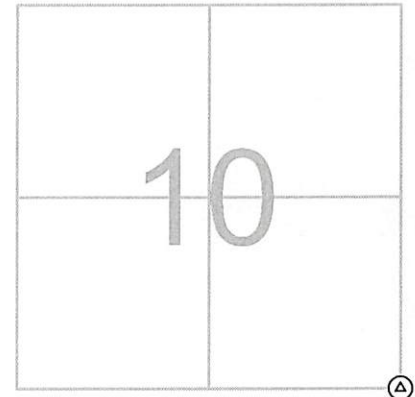

MONUMENT INFORMATION

MONUMENT TYPE: FD 3-1/2" Ø BRASS DISK
ON SURFACE - BELOW: 0.76'
LEFT - CL PAV'T - RIGHT:

BRASS DISK IN CONCRETE - ALL STAMPING WAS
BARELY LEGIBLE

SET DRILL HOLE IN CENTER OF "X" ON DISK



MISC. INFORMATION

FD PK NAIL 0.05' BELOW SURFACE, SHOT W. GPS
AND DUG FOR CONCRETE MONUMENT WITH BRASS
DISK PER RECORD. PK NAIL WAS ONLINE NORTH
AND SOUTH AND 0.03' EAST OF CENTER OF "X" ON
DISK.

APRIL 18, 2023

SET MONUMENT BOX OVER
BRASS DISK IN CONCRETE

