

# OTTAWA COUNTY ENGINEERS OFFICE

**REFERENCE NO.** 11-6-15-D  
 WEST QUARTER POST SEC. 11  
 SALEM TWP.  
**SHEET** 1 OF 1.

**ROUTE:** C-18 PORTAGE RIVER SOUTH RD.  
 @ T-226 GORDON RD.

**TOWNSHIP:** SALEM


**SECTION:** 11

T 6 NR 15 E.

**NORTHING:**

**EASTING:**

**DATUM:**

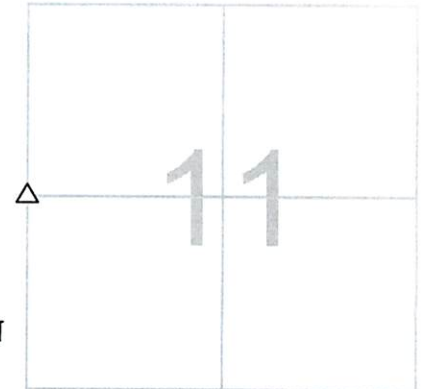

**PERSONNEL:**

M. WITTMAN, P.S.  
 J. ALLEN  
 B. JEFFRIES  
 S. ULLRICH

**DATE / WEATHER / TEMP:**

JUNE 12, 2008  
 SUNNY S  
 84° F

MONUMENT INFORMATION

MONUMENT TYPE: FD POINTED LIMESTONE  
 ON SURFACE - BELOW: 1.76'  
 LEFT - CL PAV'T - RIGHT: 6.0'  
 RECTANGULAR STONE: 4" x 2"



MISC. INFORMATION

JUNE 12, 2008

SET 1" SQUARE IRON PIN  
 IN MONUMENT BOX OVER  
 STONE

