

OTTAWA COUNTY ENGINEERS OFFICE

REFERENCE NO. 11-6-15-F
EAST QUARTER POST SEC. 11
SALEM TWP.
SHEET 1 OF 1.

ROUTE: C-18 PORTAGE RIVER SOUTH RD.
@ T-217 MUDDY CREEK NORTH RD.

TOWNSHIP: SALEM

SECTION: 11

T 6 N R 15 E.

NORTHING:

EASTING:


DATUM:

PERSONNEL:

M. WITTMAN, P.S.
J. ALLEN
S. ULLRICH
M. ULLRICH

DATE / WEATHER / TEMP:

JUNE 24, 2008
SUNNY E-NE
73° F

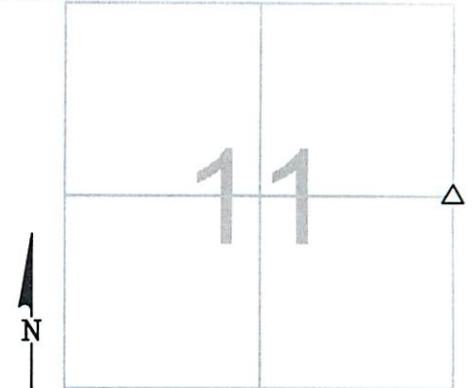

MONUMENT INFORMATION

MONUMENT TYPE: FD LIMESTONE W/ DRILL HOLE
ON SURFACE - BELOW: 1.36'
LEFT - CL PAV'T - RIGHT: 5.15'
IRREGULAR SHAPED STONE: 6" x 6" x 15"



MISC. INFORMATION

STONE WAS IN OLD ROUND MONUMENT BOX THAT HAD DRIED AC IN IT OVER THE STONE.
REMOVED OLD BOX AND AC TO EXPOSE STONE.

JUNE 24, 2008

SET 1" SQUARE IRON PIN
IN MONUMENT BOX OVER
STONE

