

OTTAWA COUNTY ENGINEERS OFFICE

REFERENCE NO. 11-6-15-I
SE CORNER POST SEC. 11
SALEM TWP.
SHEET 1 OF 1.

ROUTE: C-17 OAK HARBOR SE RD.
@ T-217 MUDDY CREEK NORTH RD.

TOWNSHIP: SALEM

SECTION: 11

T 6 NR 15 E.

PERSONNEL:
M. WITTMAN, P.S.
J. ALLEN
C. MILLER
B. BRADY


NORTHING:

EASTING:

DATUM:

DATE / WEATHER / TEMP:


APRIL 18, 2023
OVERCAST - S
38° F

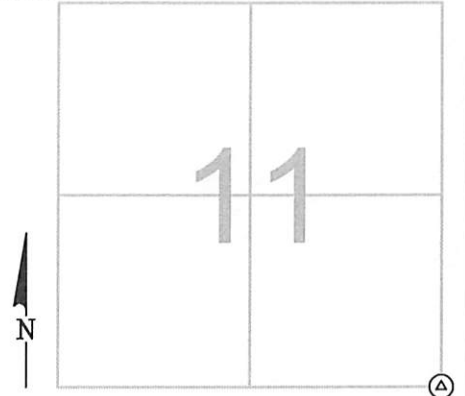

MONUMENT INFORMATION

MONUMENT TYPE: 3-1/2" Ø BRASS DISK
ON SURFACE - BELOW: 1.63'
LEFT - CL PAV'T - RIGHT: OAK HARBOR SE RD.
LEFT - CL PAV'T - RIGHT: MUDDY CREEK NORTH RD.

BRASS DISK IN CONCRETE PER RECORDS

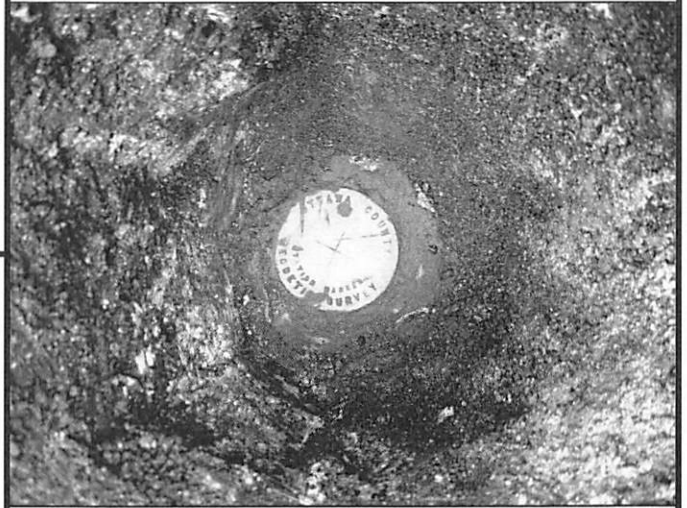

MISC. INFORMATION

FD PK NAIL 0.28' BELOW SURFACE, SHOT W/ GPS
AND DUG FOR BRASS DISK MONUMENT PER
RECORDS. PK NAIL WAS 0.03' WEST AND 0.08'
SOUTH OF "X" ON THE BRASS DISK.

APRIL 18, 2023

SET 1" SQUARE IRON PIN
IN MONUMENT BOX OVER
BRASS DISK IN CONCRETE

