

# OTTAWA COUNTY ENGINEERS OFFICE

REFERENCE NO. 12-6-15-I  
SE CORNER POST SECTION 12  
SALEM TWP.  
SHEET 1 OF 1.

ROUTE: C-17 OAK HARBOR SE RD.  
@ SALEM / BAY TWP. LINE

TOWNSHIP: SALEM

SECTION: 12

T 6 NR 15 E.


NORTHING:

EASTING:

DATUM:

PERSONNEL:  
M. WITTMAN, P.S.  
J. ALLEN


DATE / WEATHER / TEMP:  
JUNE 19, 2012  
SUNNY, W - SW  
92° F

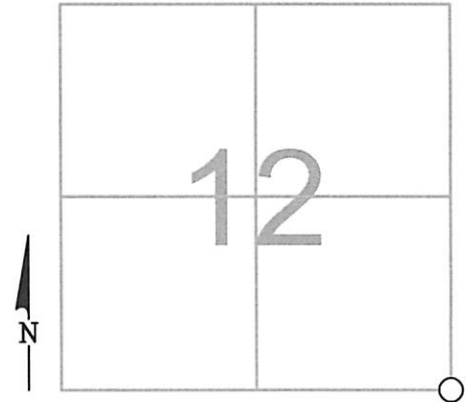

## MONUMENT INFORMATION

MONUMENT TYPE: FD. 1-1/4" Ø IRON PIN  
ON SURFACE - BELOW: 0.40'  
LEFT - CL PAV'T - RIGHT: 8.2'

PINE LEANS SLIGHTLY E - SE.

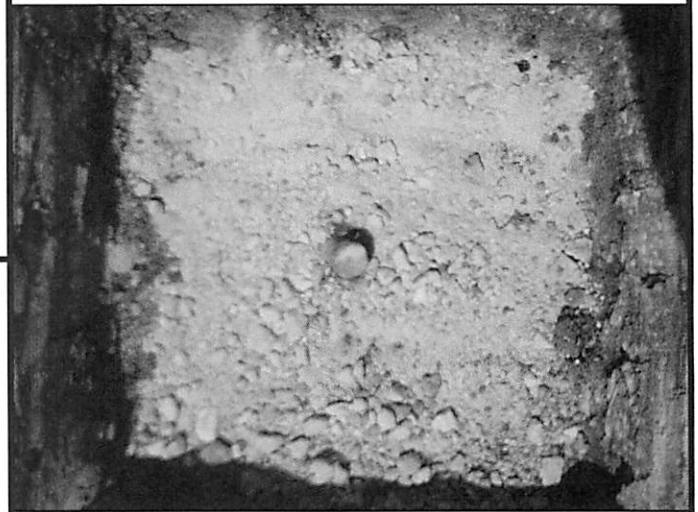

## MISC. INFORMATION

ALL TIES WERE SHOT BY GPS AND ARE THEREFORE  
PLUMB MEASUREMENTS.

JUNE 19, 2012

SET MONUMENT BOX  
OVER IRON PIN.

