

OTTAWA COUNTY ENGINEERS OFFICE

REFERENCE NO. 13-6-15-C
 NE CORNER POST SECTION 13
 SALEM TWP.
SHEET 1 OF 1.

ROUTE: C-17 OAK HARBOR SE RD.
 @ SALEM / BAY TWP. LINE

TOWNSHIP: SALEM

SECTION: 13

T 6 **NR** 15 **E.**


NORTHING:

EASTING:

DATUM:

PERSONNEL:
 M. WITTMAN, P.S.
 J. ALLEN


DATE / WEATHER / TEMP:
 JUNE 19, 2012
 SUNNY, W - SW
 92° F

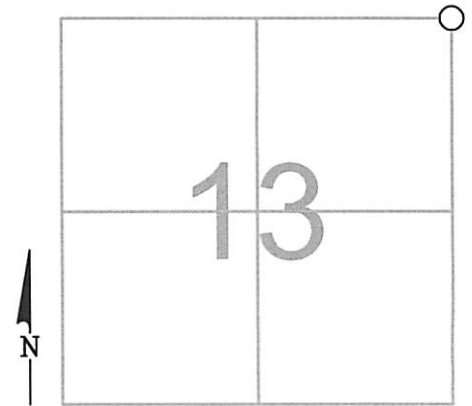

MONUMENT INFORMATION

MONUMENT TYPE: FD. 1-1/4" Ø IRON PIN
 ON SURFACE - BELOW: 0.40'
 LEFT - CL PAV'T - RIGHT: 8.2'

 PINE LEANS SLIGHTLY E - SE.

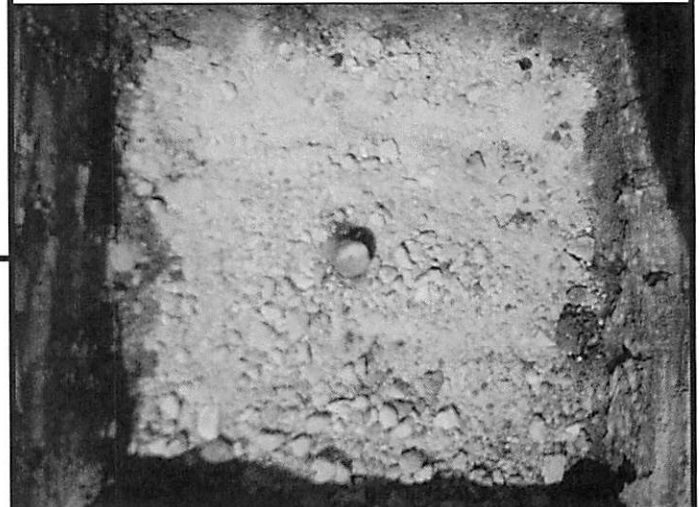

MISC. INFORMATION

ALL TIES WERE SHOT BY GPS AND ARE THEREFORE
 PLUMB MEASUREMENTS.

JUNE 19, 2012

SET MONUMENT BOX
 OVER IRON PIN.

