


OTTAWA COUNTY ENGINEERS OFFICE

REFERENCE NO. 14-6-15-B
 NORTH QUARTER POST SEC. 14
 SALEM TWP.
SHEET 1 OF 1.

ROUTE: C-17 OAK HARBOR SE RD.
TOWNSHIP: SALEM
SECTION: 14
T 6 **NR** 15 **E.**

PERSONNEL:
 M. WITTMAN, P.S.
 J. ALLEN
 B. BRADY
 M. HEINTZ

NORTHING:
EASTING:
DATUM:

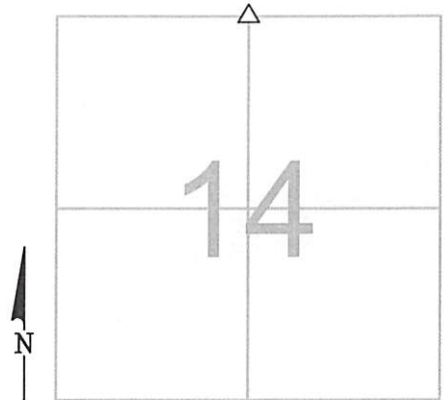

DATE / WEATHER / TEMP:
 APRIL 24, 2023
 PARTLY CLOUDY
 38° F

MONUMENT INFORMATION

MONUMENT TYPE: LIMESTONE
 ON SURFACE - BELOW: 2.00'
LEFT - CL PAV'T - RIGHT: 0.31'

5" x 10" RECTANGULAR LIMESTONE W/ CHISLED "X"
 USED "X" FOR POINT



MISC. INFORMATION

FD PK NAIL 0.03' BELOW SURFACE SHOT W/ GPS AND DUG FOR STONE. FD SQUARE HEAD BOLT 0.69 BELOW SURFACE, SHOT WITH GPS. PK NAIL WAS 0.19' EAST AND 0.02' SOUTH OF BOLT. FD IRON PIN SLANTED NORTH OVER STONE. IRON PIN APPEARED TO HAVE BEEN SET ON "X" ON STONE BUT WAS BENT NORTH. BOLT WAS 0.02' EAST AND 0.43' NORTH OF "X" ON STONE. BOLT WAS MOST LIKELY SET OVER THE BENT NORTH END OF PIN. PK NAIL WAS 0.41' NORTH AND 0.21' EAST OF "X" ON STONE.

APRIL 24, 2023

SET 1" SQUARE IRON PIN
 IN MONUMENT BOX OVER
 STONE

