

# OTTAWA COUNTY ENGINEERS OFFICE

REFERENCE NO. 15-6-15-B  
NORTH QUARTER POST SEC. 15  
SALEM TWP.  
SHEET 1 OF 1.

ROUTE: C-17 OAK HARBOR SE RD.

TOWNSHIP: SALEM

SECTION: 15

T 6 NR 15 E.


**PERSONNEL:**

M. WITTMAN, P.S.  
J. ALLEN  
B. BRADY  
T. FOCHT

NORTHING:

EASTING:

DATUM:

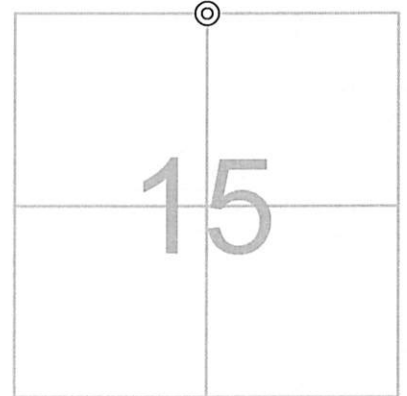

**DATE / WEATHER / TEMP:**

MAY 8, 2023  
OVERCAST - NE  
54° F

MONUMENT INFORMATION

MONUMENT TYPE: FD 3/4" Ø IRON PIPE  
ON SURFACE - BELOW: 0.64'  
LEFT - CL PAV'T - RIGHT: 0.70'

IRON PIPE PER RECORDS AND ROAD PLAN



MISC. INFORMATION

MAY 8, 2023

SET MONUMENT BOX OVER  
3/4" Ø IRON PIPE

