

# OTTAWA COUNTY ENGINEERS OFFICE

REFERENCE NO. 16-6-15-B  
NORTH QUARTER POST SEC. 16  
SALEM TWP.  
SHEET 1 OF 1.

ROUTE: T-107 CULLMAN RD.

TOWNSHIP: SALEM

SECTION: 16

T 6 NR 15 E.

PERSONNEL:  
M. WITTMAN, P.S.  
J. ALLEN  
B. JEFFRIES


NORTHING:

EASTING:

DATUM:

DATE / WEATHER / TEMP:

JULY 29, 2008  
SUNNY HUMID  
76° F

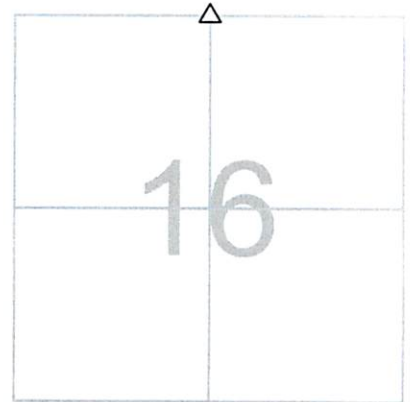

## MONUMENT INFORMATION

MONUMENT TYPE: FD POINTED STONE  
ON SURFACE - BELOW: 1.50'  
LEFT - CL PAV'T - RIGHT: 4.0'

ROUND STONE: 4 1/2" Ø x 7"

USED POINT OF STONE



## MISC. INFORMATION

JULY 29, 2008

SET 1" SQUARE IRON PIN  
IN MONUMENT BOX OVER  
STONE

