

# OTTAWA COUNTY ENGINEERS OFFICE

REFERENCE NO. 16-6-15-C  
NE CORNER POST SEC. 16  
SALEM TWP.  
SHEET 1 OF 1.

ROUTE: T-169 WOODRICK RD.  
@ T-107 CULLMAN RD.

TOWNSHIP: SALEM

SECTION: 16

T 6 NR 15 E.

PERSONNEL:  
M. WITTMAN, P.S.  
J. ALLEN


NORTHING:

EASTING:

DATUM:

DATE / WEATHER / TEMP:

MARCH 29, 2012  
OVERCAST - NE  
49° F

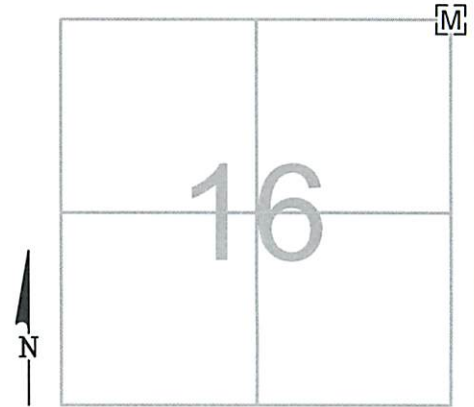

## MONUMENT INFORMATION

MONUMENT TYPE: FD 1" SQ. IRON PIN IN MON. BOX  
ON SURFACE - BELOW: 0.37'  
LEFT - CL PAV'T - RIGHT: 2.60'

PLACED RISER TO BRING TO SURFACE



## MISC. INFORMATION

