

OTTAWA COUNTY ENGINEERS OFFICE

REFERENCE NO. 16-6-15-F
 E QUARTER POST SECTION 16
 SALEM TWP.
SHEET 1 OF 1.

ROUTE: T-169 WOODRICK RD.
 @ T-6 ELMORE EASTERN RD.

TOWNSHIP: SALEM

SECTION: 16

T 6 NR 15 E.


PERSONNEL:

- M. WITTMAN, P.S.
- J. ALLEN
- K. SMITH
- J. HAYES - BEC
- M. POMMERANZ - BEC

NORTHING:

EASTING:

DATUM:

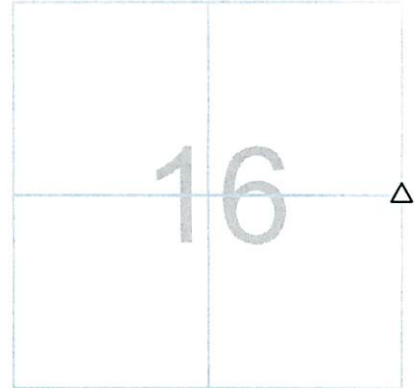

DATE / WEATHER / TEMP:

JUNE 5, 2007
 OVERCAST - DRIZZLE
 58° F

MONUMENT INFORMATION

MONUMENT TYPE: FD STONE W/ NOTCH
 ON SURFACE - BELOW: 1.42'
LEFT - CL PAV'T - RIGHT: 2'
 RECTANGULAR HARDHEAD STONE: 4" x 2"

 USED CENTER OF STONE IN NOTCH



MISC. INFORMATION

JUNE 20, 2007

SET 1" SQUARE IRON PIN
 IN MONUMENT BOX OVER
 STONE

