

OTTAWA COUNTY ENGINEERS OFFICE

REFERENCE NO. 17-6-15-A
NORTHWEST CORNER SEC. 17
SALEM TWP.
SHEET 1 OF 1.

ROUTE: T-111 PORTAGE SOUTH RD.
@ T-107 CULLMAN RD.

TOWNSHIP: SALEM

SECTION: 17

T 6 NR 15 E.

NORTHING:

EASTING:


DATUM:

PERSONNEL:

M. WITTMAN, P.S.
J. ALLEN
P. LACUMSKY - SALEM TWP.

DATE / WEATHER / TEMP:

JUNE 25, 2012
SUNNY - NE
76° F

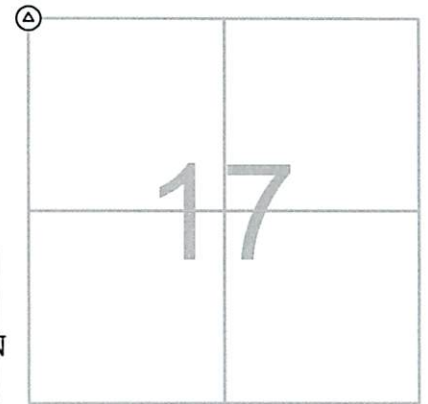

MONUMENT INFORMATION

MONUMENT TYPE: FD BRASS DISK IN CONCRETE
ON SURFACE - BELOW: 0.85'
LEFT - CL PAV'T - RIGHT: 1.10'



MISC. INFORMATION

JUNE 25, 2012

SET MONUMENT BOX
OVER DISK IN CONCRETE

