

OTTAWA COUNTY ENGINEERS OFFICE

REFERENCE NO. 17-6-15-D
WEST QUARTER POST SEC. 17
SALEM TWP.
SHEET 1 OF 1.

ROUTE: T-111 PORTAGE SOUTH RD.

TOWNSHIP: SALEM

SECTION: 17

T 6 NR 15 E.


NORTHING:

EASTING:

DATUM:

PERSONNEL:
M. WITTMAN, P.S.
J. ALLEN

DATE / WEATHER / TEMP:
OCTOBER 21, 2013
SUNNY - SW
51° F

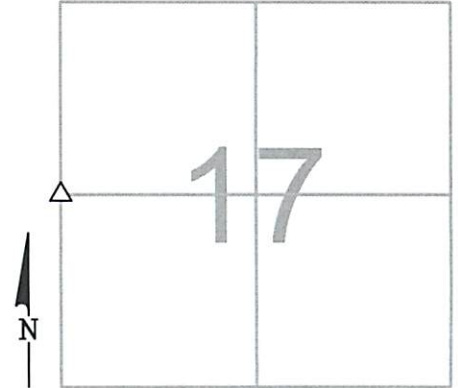

MONUMENT INFORMATION

MONUMENT TYPE: FD 6" X 5-1/2" HARDHEAD STONE
ON SURFACE - BELOW: 1.97'
LEFT - CL PAV'T - RIGHT:

USED CENTER OF STONE



MISC. INFORMATION

FD MAG SPK ON SURFACE W/ EXISTING 2'-0" TIES N,
S, E & W. DUG FOR STONE. SURFACE MAG SPK
WAS 0.03' SOUTH AND 0.07' EAST OF CENTER OF
STONE.

OCTOBER 21, 2013

SET 1" SQUARE IRON PIN
IN MONUMENT BOX OVER
STONE

