

OTTAWA COUNTY ENGINEERS OFFICE

REFERENCE NO. 17-6-15-Q
 SOUTH 1/16 POST SECTION 17
 SALEM TWP.
SHEET 1 OF 1.

ROUTE: C-6 ELMORE EASTERN RD.
 @ T-111 PORTAGE SOUTH RD.

TOWNSHIP: SALEM

SECTION: 17

T 6 **NR** 15 **E.**


NORTHING:

EASTING:

DATUM:

PERSONNEL:
 M. WITTMAN, P.S.
 J. ALLEN

DATE / WEATHER / TEMP:
 MAY 2, 2014
 OVERCAST - SW
 54° F

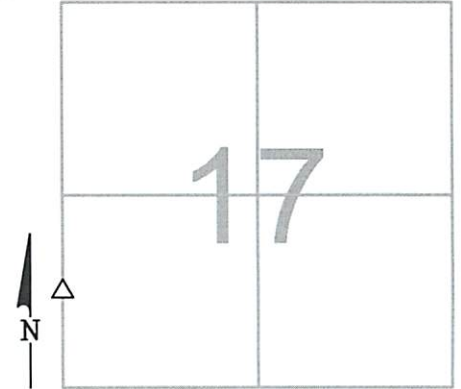

MONUMENT INFORMATION

MONUMENT TYPE: FD POINTED LIMESTONE
 ON SURFACE - BELOW: 1.93'
 LEFT - CL PAV'T - RIGHT: 1.65'

3-1/2" X 6" POINTED LIMESTONE

USED HIGH POINT ON STONE



MISC. INFORMATION

POINT WAS LOCATED BY ANGLE AND DISTANCE
 FROM WEST 1/4 OF SECTION 17 - NO PRIOR
 MONUMENTS WERE FOUND PERPETUATING THIS
 CORNER.

MAY 2, 2014

SET 1" SQUARE IRON PIN
 IN MONUMENT BOX OVER
 STONE

