


# OTTAWA COUNTY ENGINEERS OFFICE

**REFERENCE NO.** 18-6-15-B  
 NORTH QUARTER POST SEC. 18  
 SALEM TWP.  
**SHEET** 1 OF 1.

**ROUTE:** T-41 FOUR-MILE HOUSE RD.  
**TOWNSHIP:** SALEM  
**SECTION:** 18  
**T** 6 **NR** 15 **E.**

**PERSONNEL:**  
 M. WITTMAN, P.S.  
 J. ALLEN  
 J. HAYES - BEC  
 M. POMMERANZ - BEC

**NORTHING:**  
**EASTING:**  
**DATUM:**

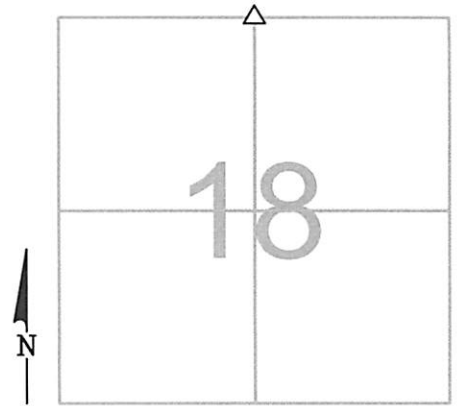

**DATE / WEATHER / TEMP:**  
 JUNE 25, 2012  
 SUNNY - NE  
 70° F

### MONUMENT INFORMATION

MONUMENT TYPE: FD POINTED HARDHEAD STONE  
 ON SURFACE - BELOW: 1.92'  
LEFT - CL PAV'T - RIGHT: 3.10'  
  
 STONE WAS 5" X 7" X 11-1/2"  
  
 USED POINT OF STONE



### MISC. INFORMATION

FD PK NAIL 0.45' BELOW SURFACE. TIED W/ X-TIES  
 AND DUG FOR STONE.  
  
 SET FAINT DRILL HOLE IN POINT OF STONE.

JUNE 25, 2012

SET 1" SQUARE IRON PIN  
 IN MONUMENT BOX OVER  
 STONE

