

# OTTAWA COUNTY ENGINEERS OFFICE

REFERENCE NO. 18-6-15-F  
EAST QUARTER POST SEC. 18  
SALEM TWP.  
SHEET 1 OF 1.

ROUTE: T-111 PORTAGE SOUTH RD.

TOWNSHIP: SALEM

SECTION: 18

T 6 NR 15 E.


NORTHING:

EASTING:

DATUM:

PERSONNEL:  
M. WITTMAN, P.S.  
J. ALLEN

DATE / WEATHER / TEMP:  
OCTOBER 21, 2013  
SUNNY - SW  
51° F

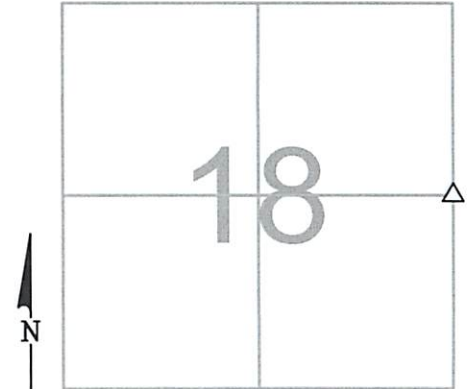

## MONUMENT INFORMATION

MONUMENT TYPE: FD 6" X 5-1/2" HARDHEAD STONE  
ON SURFACE - BELOW: 1.97'  
LEFT - CL PAV'T - RIGHT:

USED CENTER OF STONE



## MISC. INFORMATION

FD MAG SPK ON SURFACE W/ EXISTING 2'-0" TIES N,  
S, E & W. DUG FOR STONE. SURFACE MAG SPK  
WAS 0.03' SOUTH AND 0.07' EAST OF CENTER OF  
STONE.

OCTOBER 21, 2013

SET 1" SQUARE IRON PIN  
IN MONUMENT BOX OVER  
STONE

