

OTTAWA COUNTY ENGINEERS OFFICE

REFERENCE NO. 18-6-15-G
SW CORNER POST SECTION 18
SALEM TWP.
SHEET 1 OF 1.

ROUTE: C-42 HARRIS-SALEM RD.
@ C-6 ELMORE EASTERN RD.

TOWNSHIP: SALEM

SECTION: 18

T 6 NR 15 E.


NORTHING:

EASTING:

DATUM:

PERSONNEL:
M. WITTMAN, P.S.
J. ALLEN
K. SMITH
S. ULLRICH

DATE / WEATHER / TEMP:
JULY 18, 2007
OVERCAST
75° F

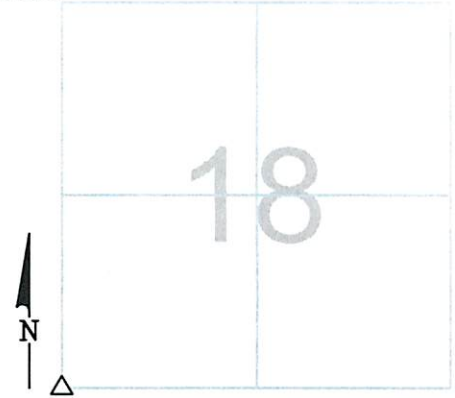

MONUMENT INFORMATION

MONUMENT TYPE: FD OTTAWA COUNTY DISK
ON SURFACE - BELOW: 1.17'
LEFT - CL PAV'T - RIGHT: 3.00'
3" BRASS DISK IN CONCRETE
SET DRILL HOLE IN CENTER OF DISK



MISC. INFORMATION

