

# OTTAWA COUNTY ENGINEERS OFFICE

**REFERENCE NO.** 18-6-15-S  
 SOUTH 1/16 POST SECTION 18  
 SALEM TWP.  
**SHEET** 1 OF 1.

**ROUTE:** C-6 ELMORE EASTERN RD.  
 @ T-111 PORTAGE SOUTH RD.

**TOWNSHIP:** SALEM

**SECTION:** 18

**T** 6 **NR** 15 **E.**


**NORTHING:**

**EASTING:**

**DATUM:**

**PERSONNEL:**  
 M. WITTMAN, P.S.  
 J. ALLEN

**DATE / WEATHER / TEMP:**  
 MAY 2, 2014  
 OVERCAST - SW  
 54° F

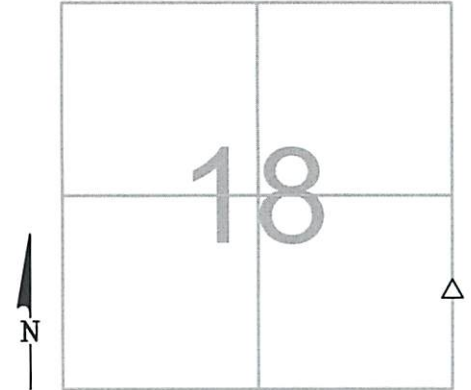

### MONUMENT INFORMATION

MONUMENT TYPE: FD POINTED LIMESTONE  
 ON SURFACE - BELOW: 1.93'  
 LEFT - CL PAV'T - RIGHT: 1.65'

3-1/2" X 6" POINTED LIMESTONE

USED HIGH POINT ON STONE



### MISC. INFORMATION

POINT WAS LOCATED BY ANGLE AND DISTANCE  
 FROM WEST 1/4 OF SECTION 17 - NO PRIOR  
 MONUMENTS WERE FOUND PERPETUATING THIS  
 CORNER.

MAY 2, 2014

SET 1" SQUARE IRON PIN  
 IN MONUMENT BOX OVER  
 STONE

