

# OTTAWA COUNTY ENGINEERS OFFICE

REFERENCE NO. 19-6-15-B  
N QUARTER POST SECTION 19  
SALEM TWP.  
SHEET 1 OF 1.

ROUTE: T-41 FOUR-MILE HOUSE RD.

TOWNSHIP: SALEM

SECTION: 19

T 6 NR 15 E.


**PERSONNEL:**

M. WITTMAN, P.S.  
J. ALLEN  
K. SMITH  
S. ULLRICH

NORTHING:

EASTING:

DATUM:

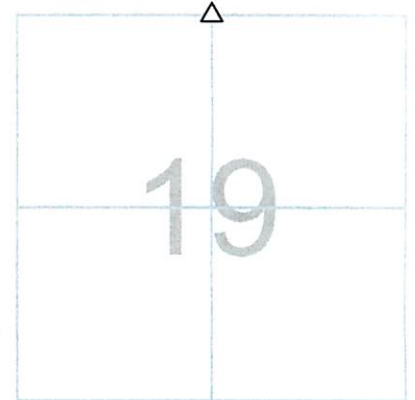

**DATE / WEATHER / TEMP:**

JULY 31, 2007  
SUNNY  
83° F

MONUMENT INFORMATION

MONUMENT TYPE: FD STONE W/ NOTCH  
ON SURFACE - BELOW: 1.10'  
LEFT - CL PAV'T - RIGHT:  
RECTANGULAR STONE: 4" x 10" W/ NOTCH AND  
DRILL HOLE IN CENTER OF NOTCH



MISC. INFORMATION

JULY 31, 2007

SET 1" SQUARE IRON PIN  
IN MONUMENT BOX OVER  
STONE

