

OTTAWA COUNTY ENGINEERS OFFICE

REFERENCE NO. 19-6-15-E
CENTER POST SEC. 19
SALEM TWP.
SHEET 1 OF 1.

ROUTE: T- 41 FOUR-MILE HOUSE RD.
@ T- 110 BLOOM RD.

TOWNSHIP: SALEM

SECTION: 19

T 6 NR 15 E.


NORTHING:

EASTING:

DATUM:

PERSONNEL:
M. WITTMAN, P.S.
J. ALLEN

DATE / WEATHER / TEMP:
MARCH 29, 2012
OVERCAST - NE
45° F

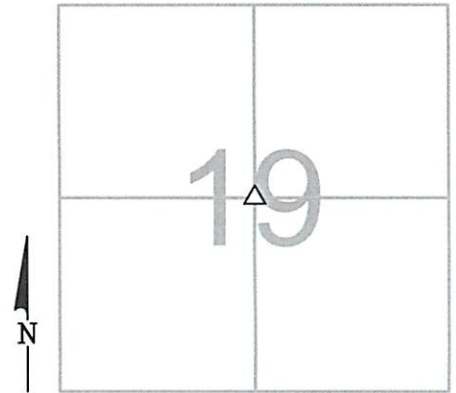

MONUMENT INFORMATION

MONUMENT TYPE: FD. 3" X 5" X 14" LIMESTONE
ON SURFACE - BELOW: 1.40'
LEFT - CL PAV'T - RIGHT: 4.0'

POINTED LIMESTONE

USED POINT OF STONE



MISC. INFORMATION

FD RAILROAD SPIKE 1½" BELOW SURFACE TIED
WITH X-TIES AND DUG FOR STONE

MARCH 29, 2012

SET 1" SQUARE IRON PIN
IN MONUMENT BOX OVER
STONE

