

# OTTAWA COUNTY ENGINEERS OFFICE

**REFERENCE NO.** 19-6-15-G  
 SW CORNER POST SECTION 19  
 SALEM TWP.  
**SHEET** 1 OF 1.

**ROUTE:** C-42 HARRIS-SALEM RD.  
 @ T-9 SCHNEIDER RD.

**TOWNSHIP:** SALEM

**SECTION:** 19

T 6 NR 15 E.


**NORTHING:**

**EASTING:**

**DATUM:**


**PERSONNEL:**  
 M. WITTMAN, P.S.  
 J. ALLEN  
 K. SMITH  
 S. ULLRICH

**DATE / WEATHER / TEMP:**  
 JULY 18, 2007  
 SUNNY  
 75° F

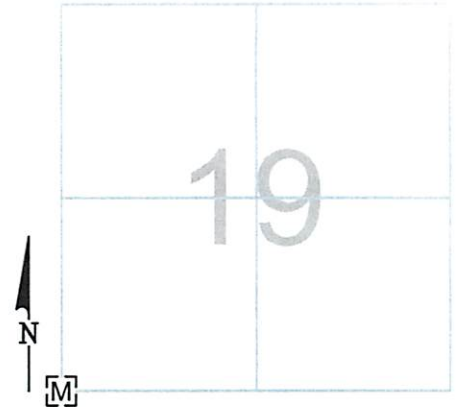

### MONUMENT INFORMATION

MONUMENT TYPE: FD 1-1/4" SQ. IRON PIN IN  
 MONUMENT BOX  
 ON SURFACE - BELOW: 0.51'  
LEFT - CL PAV'T - RIGHT: 3.85'

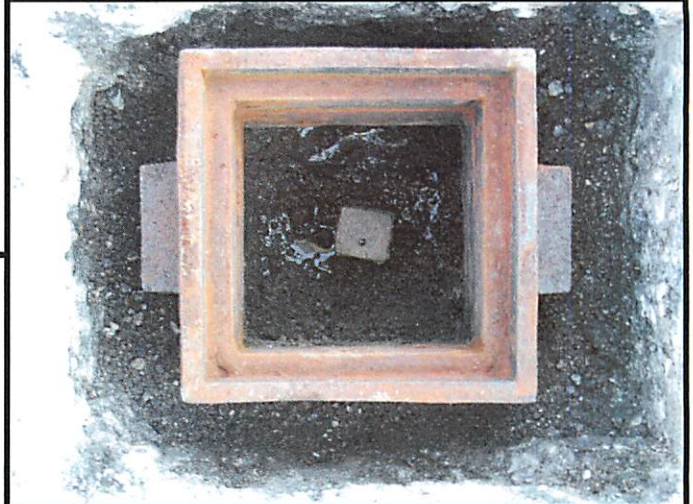

### MISC. INFORMATION

6-21-1968 FD. HARDHEAD STONE 10" x 8" TOP  
 14-3/8" BELOW SURFACE.

5-17-1971 - SET DRILL HOLE IN STONE

7-23-1971 - SET IRON PIN IN MONUMENT BOX  
 OVER STONE

