

# OTTAWA COUNTY ENGINEERS OFFICE

REFERENCE NO. 19-6-15-H  
SOUTH QUARTER POST SEC. 19  
SALEM TWP.  
SHEET 1 OF 1.

ROUTE: T-41 FOUR MILE HOUSE RD.  
@ T-9 SCHNEIDER RD.

TOWNSHIP: SALEM

SECTION: 19

T 6 NR 15 E.


NORTHING:

EASTING:

DATUM:

PERSONNEL:  
M. WITTMAN, P.S.  
J. ALLEN

DATE / WEATHER / TEMP:  
MARCH 29, 2012  
OVERCAST - NE  
43° F

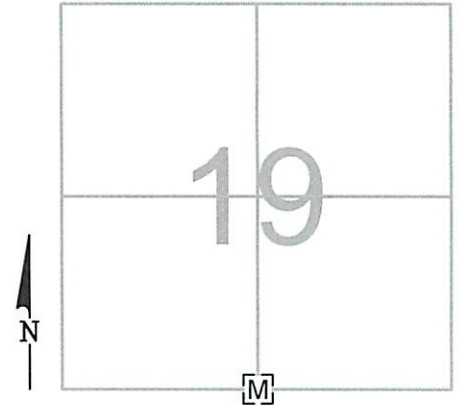

## MONUMENT INFORMATION

MONUMENT TYPE: FD. 1" SQ. IRON PIN IN MON. BOX  
ON SURFACE - BELOW: 0.37'  
LEFT - CL PAV'T - RIGHT: 5.60'



## MISC. INFORMATION

PLACED RISER TO BRING TO SURFACE

