

OTTAWA COUNTY ENGINEERS OFFICE

REFERENCE NO. 2-6-15-A
NW CORNER POST SEC. 2
SALEM TWP.
SHEET 1 OF 1.

PERSONNEL:
M. WITTMAN, P.S.
J. ALLEN

DATE / WEATHER / TEMP:
JUNE 13, 2016
SUNNY - E
68° F

ROUTE: T-101 LEUTZ RD.

TOWNSHIP: SALEM


SECTION: 2

T 6 NR 15 E.

NORTHING:

EASTING:

DATUM:

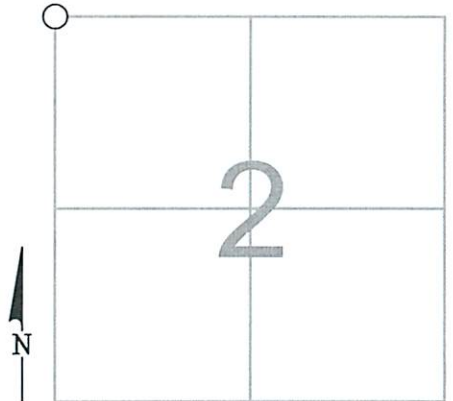

MONUMENT INFORMATION

MONUMENT TYPE: FD. 5/8" Ø IRON PIN
ON SURFACE - BELOW: 0.65'
LEFT - CL PAV'T - RIGHT: 15.30'



MISC. INFORMATION

THIS POINT IS OFF WEST SIDE OF PAVEMENT IN SHOULDER AND IS COVERED BY A 4" Ø TIN CAN.

JUNE 13, 2016

FD 5/8" Ø IRON PIN

