

OTTAWA COUNTY ENGINEERS OFFICE

REFERENCE NO. 2-6-15-B
NORTH QUARTER POST SEC. 2
SALEM TWP.
SHEET 1 OF 1.

ROUTE: T-103 ATWATER RD.

TOWNSHIP: SALEM

SECTION: 2

T 6 NR 15 E.


NORTHING:

EASTING:

DATUM:

PERSONNEL:
M. WITTMAN, P.S.
J. ALLEN

DATE / WEATHER / TEMP:
MAY 17, 2012
SUNNY E
66° F

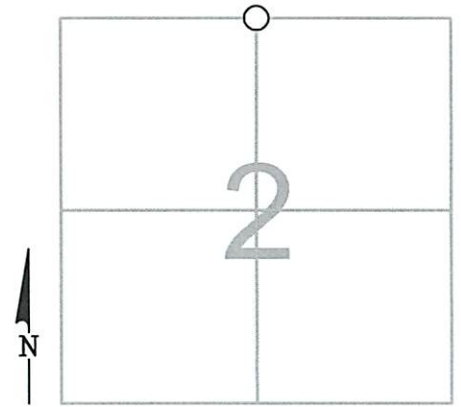

MONUMENT INFORMATION

MONUMENT TYPE: 1" Ø IRON PIN
ON SURFACE - BELOW: 0.58'
LEFT - CL PAV'T - RIGHT: 9.90'



MISC. INFORMATION

IRON PIN IS 2.30' WEST OF WEST EDGE OF
PAVEMENT IN ROADSIDE DITCH BANK.

THIS IS A CLOSING CORNER

