

OTTAWA COUNTY ENGINEERS OFFICE

REFERENCE NO. 2-6-15-E
CENTER POST SEC. 2
SALEM TWP.
SHEET 1 OF 1.

PERSONNEL:
M. WITTMAN, P.S.
J. ALLEN

DATE / WEATHER / TEMP:
JULY 1, 2015
SUNNY - W
75° F

ROUTE: T-103 ATWATER RD.
@ STATE ROUTE #163

TOWNSHIP: SALEM


SECTION: 2

T 6 NR 15 E.

NORTHING:

EASTING:

DATUM:

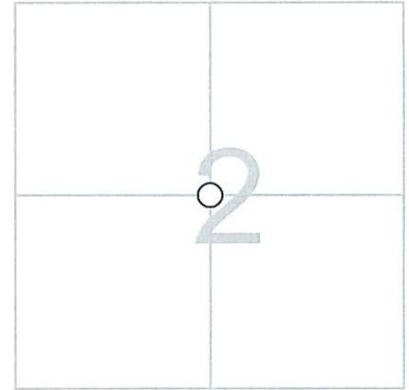

MONUMENT INFORMATION

MONUMENT TYPE: FD 3/4" SQ IRON PIN
ON SURFACE - BELOW: 0.30'
LEFT - CL PAV'T - RIGHT: 4.40'

SET MONUMENT BOX OVER IRON PIN



MISC. INFORMATION

JULY 1, 2015

SET MONUMENT BOX OVER
IRON PIN

