

OTTAWA COUNTY ENGINEERS OFFICE

REFERENCE NO. 21-6-15-F
EAST QUARTER POST SEC. 21
SALEM TWP.
SHEET 1 OF 1.

ROUTE: T-110 BLOOM RD.
@ T-169 WOODRICK RD.

TOWNSHIP: SALEM

SECTION: 21

T 6 NR 15 E.

NORTHING:


EASTING:

DATUM:

PERSONNEL:
M. WITTMAN, P.S.
J. ALLEN

DATE / WEATHER / TEMP:

AUGUST 6, 2021
SUNNY - W
83° F

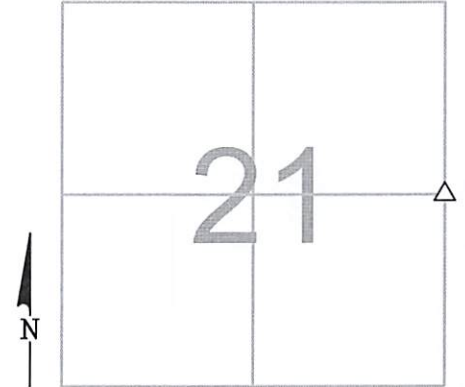

MONUMENT INFORMATION

MONUMENT TYPE: FD LIMESTONE W/ DH
ON SURFACE - BELOW: 1.73'
LEFT - CL PAV'T - RIGHT: 7.00' BLOOM RD.
LEFT - CL PAV'T - RIGHT: 1.50' WOODRICK RD.

4" x 5" RECTANGULAR LIMESTONE W/ DH
USED DH IN STONE



MISC. INFORMATION

FD MAG SPIKE ON SURFACE WITH 2'-0" MAG NAIL
TIES N, S, E. TIED W/ X-TIES AND DUG FOR STONE.
MAG SPIKE WAS ONLINE NORTH AND SOUTH AND
0.08' WEST OF DH IN STONE.

AUGUST 6, 2021

SET 1" SQUARE IRON PIN
IN MONUMENT BOX OVER
STONE

