OTTAWA COUNTY ENGINEERS OFFICE

REFERENCE NO. 21-6-15-I

SE CORNER POST SEC. 21

SALEM TWP.

SHEET 1 OF 1.

PERSONNEL:

M. WITTMAN, P.S. J. ALLEN

ROUTE: T-169 WOODRICK RD. @ SANDUSKY COUNTY LINE

TOWNSHIP: SALEM

SECTION: 21

T 6 NR 15 E.


NORTHING:

EASTING:

DATE / WEATHER / TEMP:

AUGUST 6, 2021 SUNNY - W 81° F

DATUM:

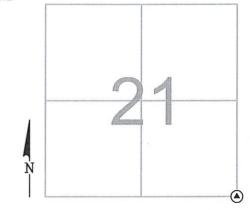

MONUMENT INFORMATION

MONUMENT TYPE: FD CONCRETE MONUMENT ON SURFACE - BELOW: 0.57' LEFT - CL PAV'T - RIGHT:

FD 6" Ø CONCRETE MONUMENT WITH 3-1/4" Ø BRASS DISK (OTTAWA COUNTY) W/ DH

MISC. INFORMATION

FD RAILROAD SPIKE 0.9' BELOW SURFACE, TIED W/ X-TIES AND DUG FOR CONCRETE MONUMENT. CENTER OF RAILROAD SPIKE WAS ONLINE NORTH AND SOUTH AND WAS 0.06' WEST OF DH IN DISK.



AUGUST 6, 2021

SET MONUMENT BOX OVER CONCRETE MONUMENT

SET MAG SET MAG NAIL OTTAWA COUNTY SANDUSKY COUNTY RD., SANDUSKY CO WITNESS WOODRICK F MARKER #169

SALEM TOWNSHIP

RICE TOWNSHIP