

OTTAWA COUNTY ENGINEERS OFFICE

REFERENCE NO. 22-6-15-C
NE CORNER POST SEC. 22
SALEM TWP.
SHEET 1 OF 1.

ROUTE: C-108 HETRICK RD.
@ T-168 BOLSINGER RD.

TOWNSHIP: SALEM

SECTION: 22

T 6 NR 15 E.

NORTHING:

EASTING:

DATUM:

PERSONNEL:

M. WITTMAN, P.S.
J. ALLEN
B. BRADY
T. FOCHT
J. RACE

DATE / WEATHER / TEMP:

MAY 10, 2023
SUNNY - E
68° F



MONUMENT INFORMATION


MONUMENT TYPE: FD CONCRETE MONUMENT
ON SURFACE - BELOW: 1.36'
LEFT - CL PAV'T - RIGHT: 0.40' HETRICK ROAD
LEFT - CL PAV'T - RIGHT: 1.00' BOLSINGER ROAD

BRASS SHAFT FROM BRASS DISK IN CONCRETE



MISC. INFORMATION

FD RR SPIKE 0.25' BELOW SURFACE, TIED WITH X-TIES AND DUG FOR BRASS DISK ON RECORD. FD CONCRETE MONUMENT WITH BROKEN OFF SIDES, ALL THAT REMAINED OF THE DISK WAS THE SHAFT IN CONCRETE. FD MONUMENT WAS SOLID AND ACCEPTED AS CORRECT POINT. RR SPIKE WAS 0.10' NORTH AND ONLINE EAST AND WEST.

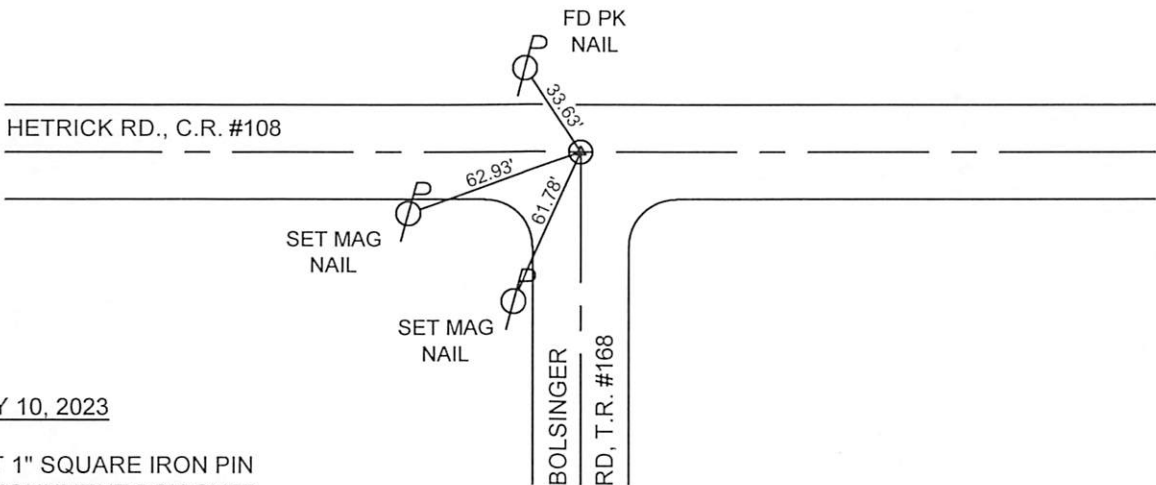

MAY 10, 2023

SET 1" SQUARE IRON PIN
IN MONUMENT BOX OVER
BRASS SHAFT IN CONCRETE