

# OTTAWA COUNTY ENGINEERS OFFICE

**REFERENCE NO.** 22-6-15-G  
 SW CORNER POST SEC. 22  
 SALEM TWP.  
**SHEET** 1 OF 1.

**ROUTE:** T-169 WOODRICK RD.  
 @ SANDUSKY COUNTY LINE

**TOWNSHIP:** SALEM

**SECTION:** 22


T 6 NR 15 E.

**PERSONNEL:**  
 M. WITTMAN, P.S.  
 J. ALLEN

**NORTHING:**

**EASTING:**

**DATUM:**

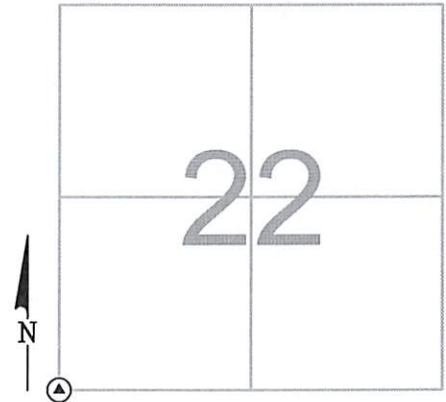

**DATE / WEATHER / TEMP:**  
 AUGUST 6, 2021  
 SUNNY - W  
 81° F

### MONUMENT INFORMATION

MONUMENT TYPE: FD CONCRETE MONUMENT  
 ON SURFACE - BELOW: 0.57'  
 LEFT - CL PAV'T - RIGHT:  
  
 FD 6" Ø CONCRETE MONUMENT WITH 3-1/4" Ø  
 BRASS DISK (OTTAWA COUNTY) W/ DH



### MISC. INFORMATION

FD RAILROAD SPIKE 0.9' BELOW SURFACE, TIED  
 W/ X-TIES AND DUG FOR CONCRETE MONUMENT.  
 CENTER OF RAILROAD SPIKE WAS ONLINE  
 NORTH AND SOUTH AND WAS 0.06' WEST OF DH  
 IN DISK.

AUGUST 6, 2021

SET MONUMENT BOX OVER  
 CONCRETE MONUMENT

