## OTTAWA COUNTY ENGINEERS OFFICE

ROUTE: T-168 BOLSINGER RD.

REFERENCE NO. 22-6-15-I

SE CORNER POST SEC. 22

SALEM TWP. SHEET 1 OF 1.

TOWNSHIP: SALEM

SECTION: 22

PERSONNEL: T 6 NR 15 E. M. WITTMAN, P.S.

NORTHING:

**EASTING:** 


DATE / WEATHER / TEMP:

APRIL 22, 2010 SUNNY - E 52° F

J. ALLEN

E. KOCH C. MILLER

DATUM:

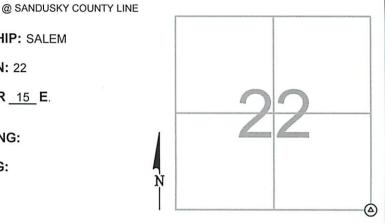

## MONUMENT INFORMATION

MONUMENT TYPE: FD. OTTAWA COUNTY BRASS DISK WITH "+" IN 6" Ø CONRETE MONUMENT ON SURFACE - BELOW: 1.38'

LEFT - CL PAV'T - RIGHT: 5.00'

USED "+" ON DISK

## MISC. INFORMATION

FD. RR SPK 0.8' BELOW SURFACE. TIED WITH X-TIES AND DUG FOR STONE. RR PK WAS 0.03'S AND 0.01' W OF "+" ON DISK.



## APRIL 22, 2010

SET 1" SQUARE IRON PIN IN MONUMENT BOX OVER DISK IN CONCRETE

WOODRICH RD., T.R. #157

SANDUSKY COUNTY

#168 BOLSINGER F T.R. #168 PBS SET MAG œ NAIL IN SIREN POLE #510 CHURCH RD., T.R. #170 SET MAG NAIL