

# OTTAWA COUNTY ENGINEERS OFFICE

**REFERENCE NO.** 23-6-15-G  
 SW CORNER POST SEC. 23  
 SALEM TWP.  
**SHEET** 1 OF 1.

**ROUTE:** T-168 BOLSINGER RD.  
 @ SANDUSKY COUNTY LINE

**TOWNSHIP:** SALEM


**SECTION:** 23

**T** 6 **N** 15 **E.**

**NORTHING:**

**EASTING:**

**DATUM:**

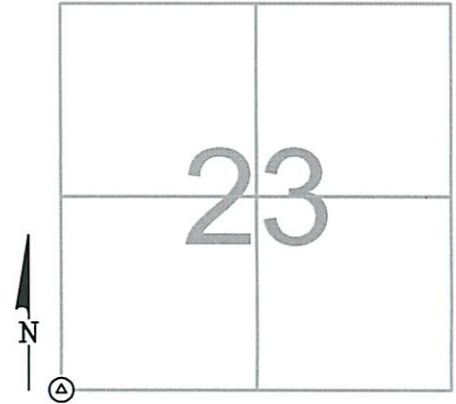

**PERSONNEL:**  
 M. WITTMAN, P.S.  
 J. ALLEN  
 E. KOCH  
 C. MILLER

**DATE / WEATHER / TEMP:**  
 APRIL 22, 2010  
 SUNNY - E  
 52° F

### MONUMENT INFORMATION

MONUMENT TYPE: FD. OTTAWA COUNTY BRASS  
 DISK WITH "+" IN 6" Ø CONCRETE MONUMENT  
 ON SURFACE - BELOW: 1.38'  
LEFT - CL PAV'T - RIGHT: 5.00'  
  
 USED "+" ON DISK



### MISC. INFORMATION

FD. RR SPK 0.8' BELOW SURFACE. TIED WITH X-TIES  
 AND DUG FOR STONE. RR PK WAS 0.03'S AND 0.01'  
 W OF "+" ON DISK.

APRIL 22, 2010

SET 1" SQUARE IRON PIN  
 IN MONUMENT BOX OVER  
 DISK IN CONCRETE

