

OTTAWA COUNTY ENGINEERS OFFICE

REFERENCE NO. 23-6-15-H
SOUTH QUARTER POST SEC 23
SALEM TWP.
SHEET 1 OF 1.

ROUTE: T-11 WOODRICH RD
@ T-38 STUMP RD

TOWNSHIP: SALEM

SECTION: 23

T 6 NR 15 E.

NORTHING:

EASTING:


DATUM:

PERSONNEL:

M. WITTMAN, P.S.
J. ALLEN
J. LAUBACHER
DEAN SILVA, PS SANDUSKY CO
STEVE FISHER, SANDUSKY CO

DATE / WEATHER / TEMP:

JUNE 24, 2011
OUTCAST DRIZZLE SW
65° F

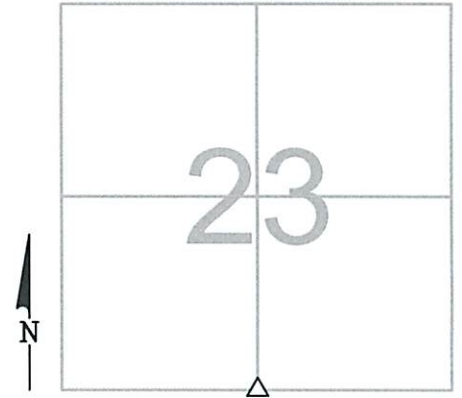

MONUMENT INFORMATION

MONUMENT TYPE: FD POINTED LIMESTONE
ON SURFACE - BELOW: 1.35'
LEFT - CL PAV'T - RIGHT: 0.35'
TRIANGULAR STONE: 4"X8"X11"



MISC. INFORMATION

FD 3/4" Ø PINCH PIPE 0.33' BELOW SURFACE
TIED W/ X-TIES & DUG FOR STONE
USED POINT OF STONE
PIPE WAS 0.03' W OF POINT OF STONE
PIPE WAS 11.5" LONG

JUNE 24, 2011

SET 1" SQUARE IRON PIN
IN MONUMENT BOX OVER
STONE

