

OTTAWA COUNTY ENGINEERS OFFICE

REFERENCE NO. 23-6-15-1
SE CORNER POST SECTION 23
SALEM TWP.
SHEET 1 OF 1.

ROUTE: T-217 MUDDY CREEK NORTH RD.
@ T-11 WOODRICH RD.

TOWNSHIP: SALEM

SECTION: 23

T 6 NR 15 E.


NORTHING:

EASTING:

DATUM:

PERSONNEL:
M. WITTMAN, P.S.
J. ALLEN

DATE / WEATHER / TEMP:
APRIL 22, 2014
SUNNY - NW
65° F

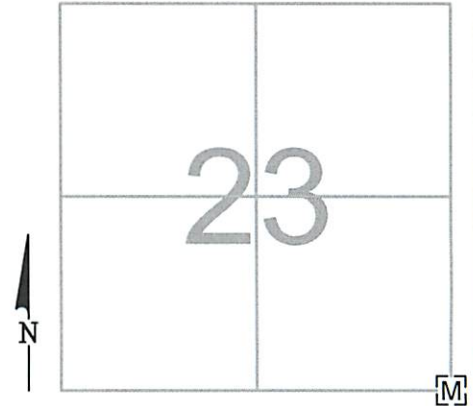

MONUMENT INFORMATION

MONUMENT TYPE: FD 5/8" Ø IRON PIN IN MON BOX
ON SURFACE - BELOW:
LEFT - CL PAV'T - RIGHT:



MISC. INFORMATION

