


OTTAWA COUNTY ENGINEERS OFFICE

REFERENCE NO. 3-6-15-B
NORTH QUARTER POST SEC. 3
SALEM TWP.
SHEET 1 OF 1.

PERSONNEL:
M. WITTMAN, P.S.
J. ALLEN
J. HAYES - BEC ASSOC.
S. MARTIN - BEC ASSOC.

DATE / WEATHER / TEMP:
AUGUST 24, 2017
OVERCAST
73° F

ROUTE:
TOWNSHIP: SALEM
SECTION: 3
T 6 NR 15 E.
NORTHING: 674449.1191
EASTING: 1799775.3795
DATUM: ODOT VRS (NAD83) 2011

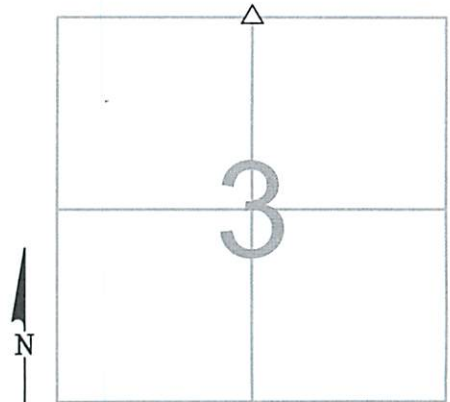

MONUMENT INFORMATION

MONUMENT TYPE: FD 4" X 5" LIMESTONE
ON SURFACE - BELOW: 1.34'
LEFT - CL PAV'T - RIGHT:
LIMESTONE IS IRREGULAR IN SHAPE.
USED CENTER OF STONE.
SET DELINEATOR 1.00' SOUTH OF STONE.



MISC. INFORMATION

COORDINATES LISTED WERE PROVIDED BY BEC ASSOCIATES, INC. ON 8-24-2017.

THIS IS A CLOSING CORNER.

AUGUST 24, 2017

SET DELINEATOR 1.00' SOUTH
OF STONE

